

DATUM ELEV = 145.00

DATUM ELEV = 145.00

DATUM ELEV = 145.00

DATUM ELEV = 145.00

STA. 400+55, 44' LT.
BUILD NEW 48" DIA. C.B.
T.G. 152.94
INV. 146.40 18" OPTION PIPE, N OUT


STA. 400+47.58

STA. 399+97.58

STA. 400+05, 30' RT.
BUILD NEW 48" DIA. C.B.
T.G. 153.19
INV. 147.65 18" OPTION PIPE, N OUT

STA. 399+47.58

STA. 399+39.58

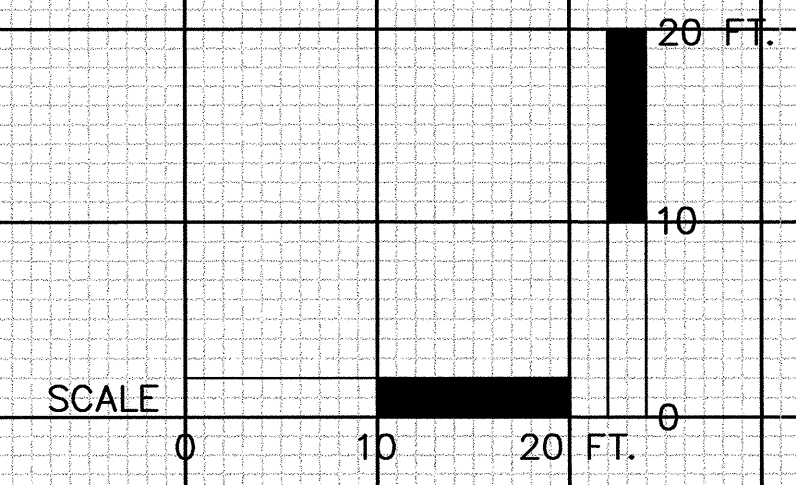

ERDMAN ANTHONY
CONSULTING ENGINEERS
Rochester, New York Camp Hill, Pennsylvania
Boston, Massachusetts

AS-BUILT REVISIONS		REVISED SEWER DESIGN	
NO.	DATE	DESCRIPTION	DATE
1.	8/29/06	CHANGES MADE PER AS-BUILTS MARK UPS	4/4/03

SHELBURNE - SOUTH BURLINGTON
STA. 399+40 TO STA. 400+48
SURVEYED BY: V.S.C. INC. DATE: _____
DRAWN BY: E.A.A. INC. DATE: _____
TRACED BY: E.A.A. INC. DATE: _____
PROJECT: NH-EGC-019-4(28)
CROSS-SECTION DWG. NO. 103
SHEET 195R OF 283