
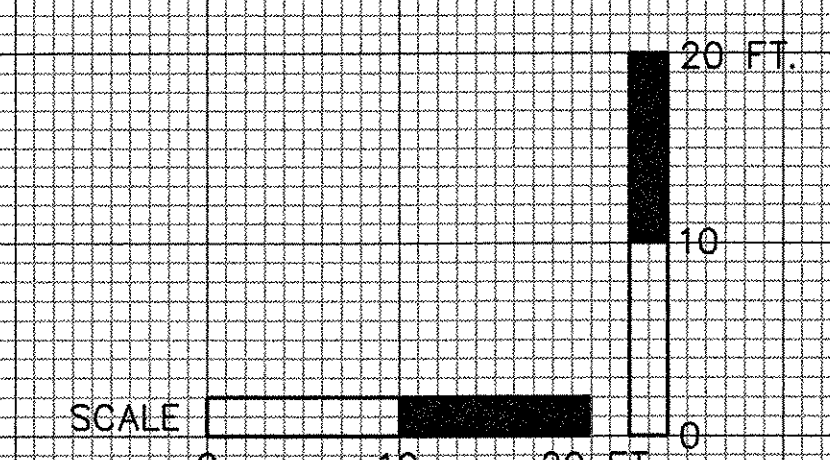


DATUM ELEV = 145.00

DATUM ELEV = 145.00

DATUM ELEV = 145.00

DATUM ELEV = 145.00

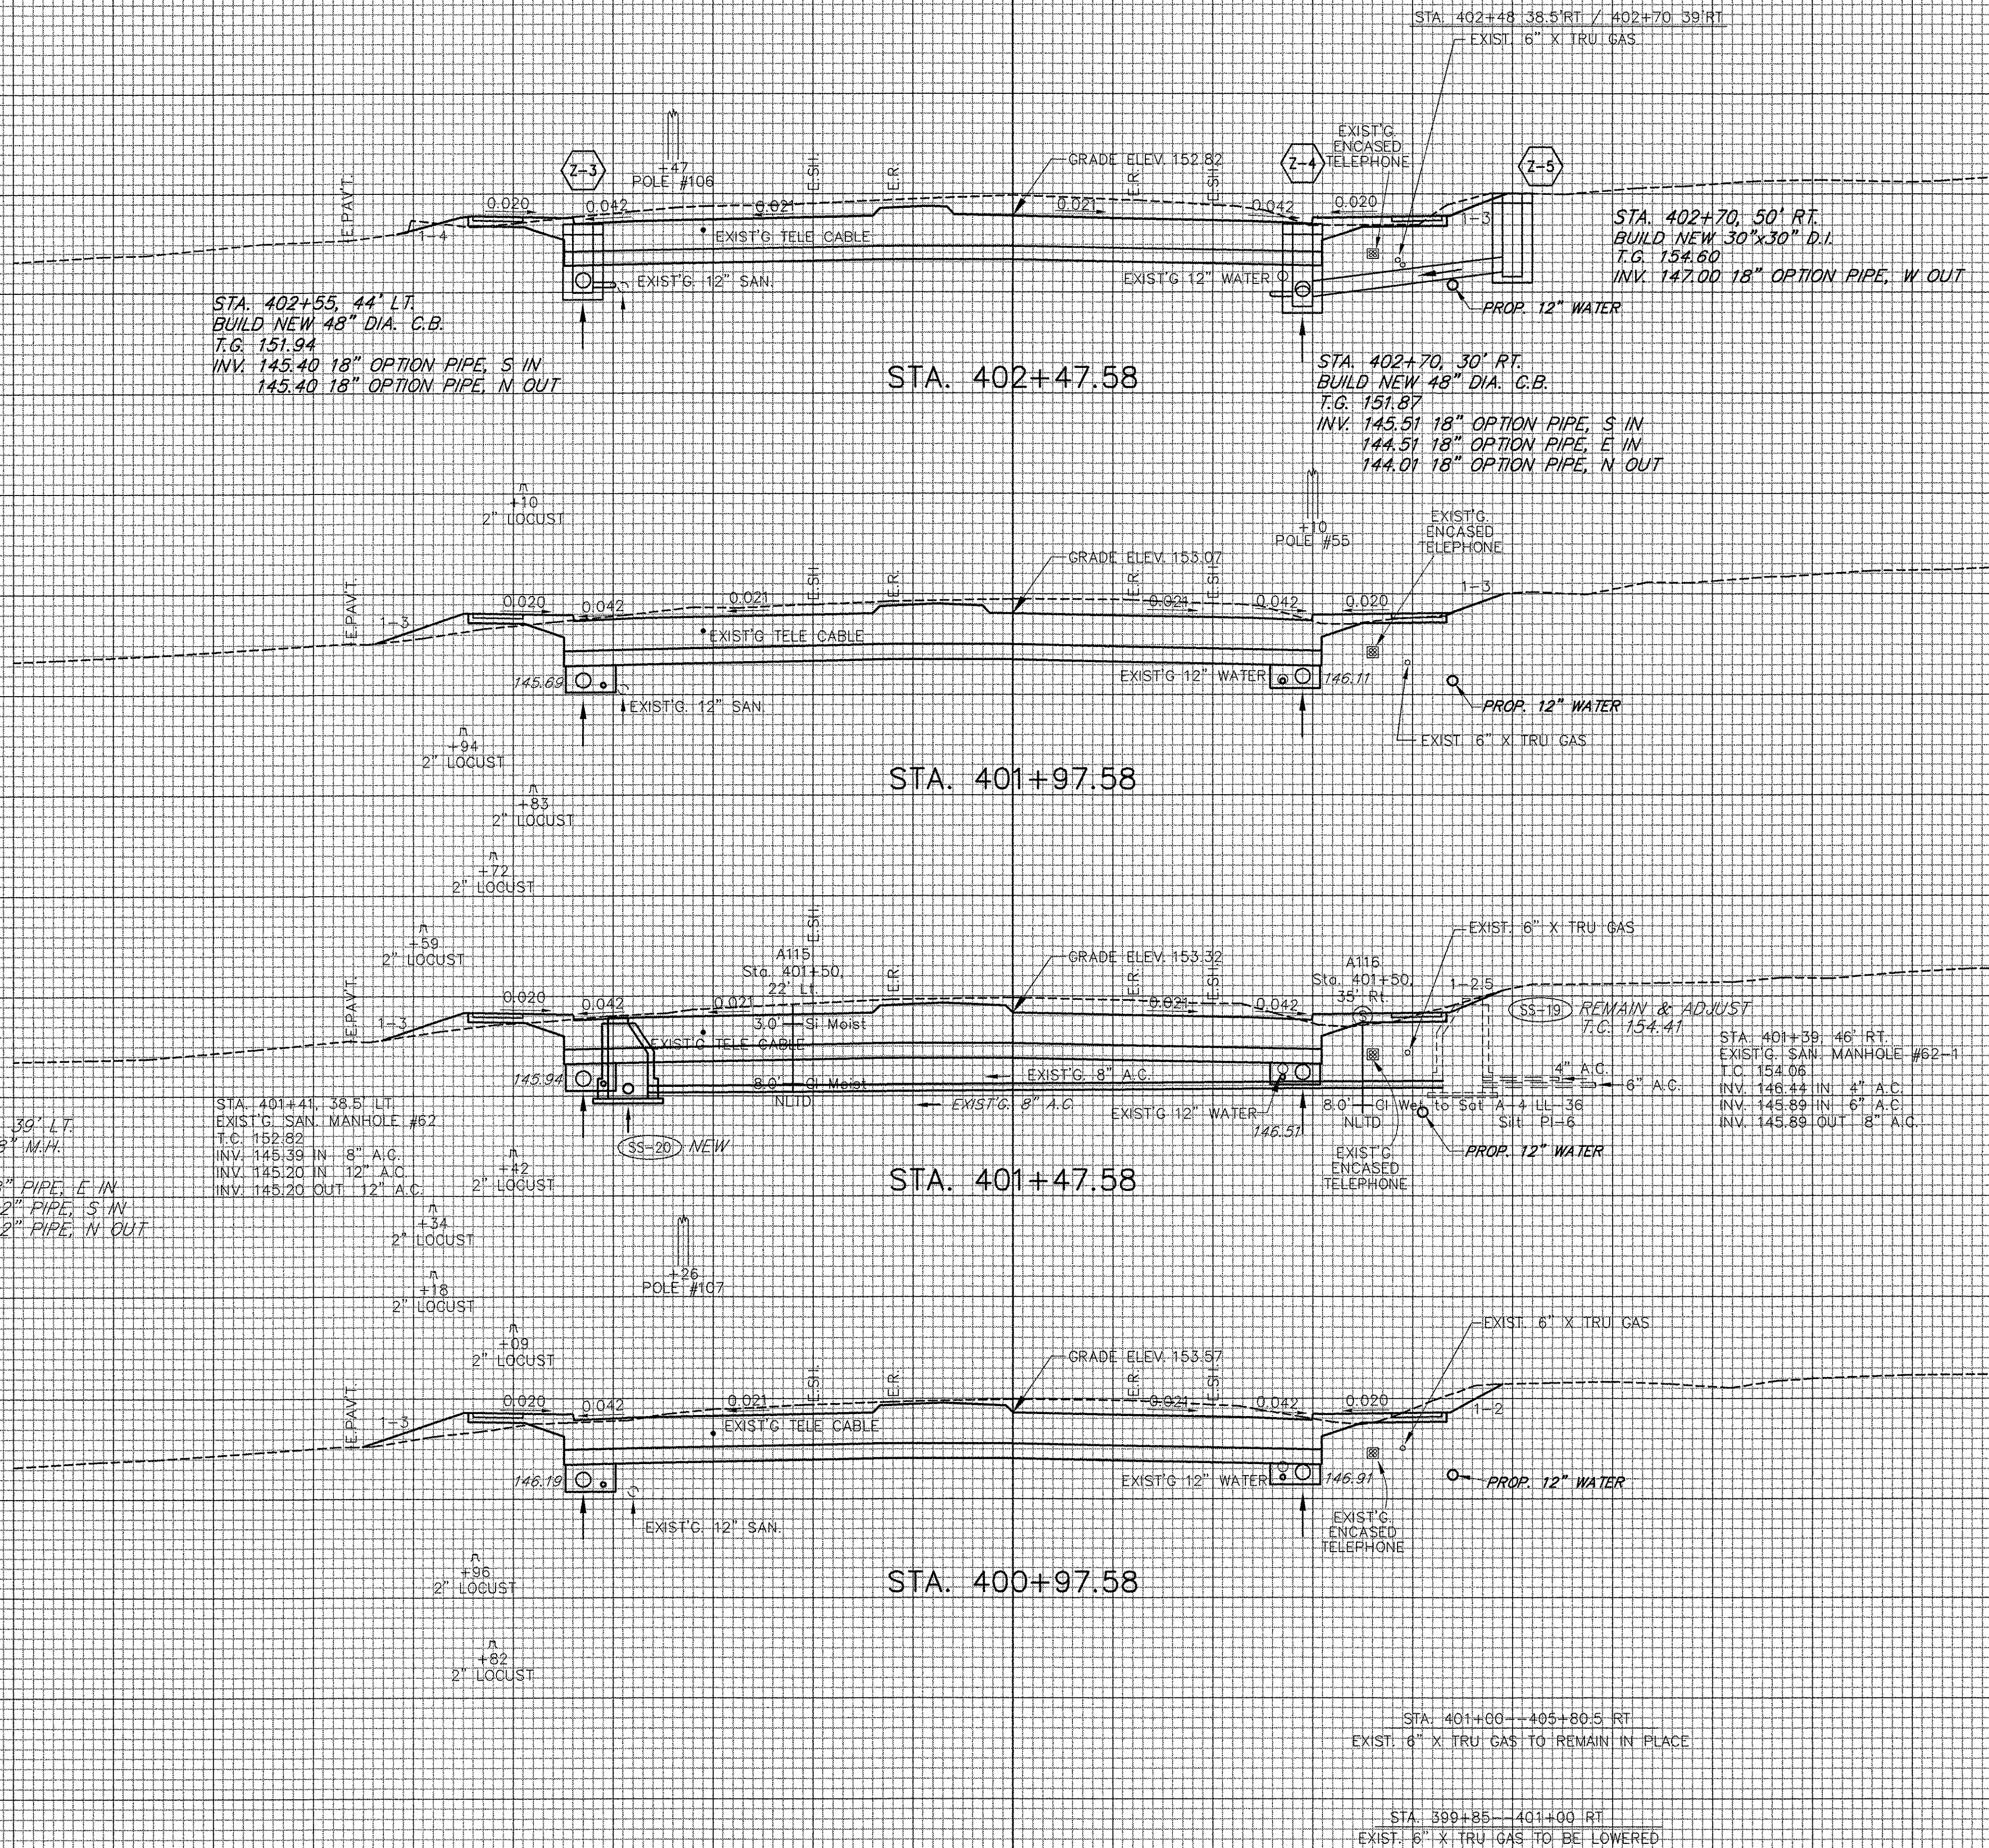

SHELburnE - SOUTH BURLINGTON

STA. 400+98 TO STA. 402+48

SURVEYED BY V.S.C. INC. DATE _____

DRAWN BY E.A.A. INC. DATE _____

TRACED BY E.A.A. INC. DATE _____

PROJECT NH-EGC-019-4(28)

CROSS-SECTION DWG. NO. 104

SHEET 196 OF 283

ERDMAN ANTHONY
CONSULTING ENGINEERS

Rochester, New York Camp Hill, Pennsylvania
Boston, Massachusetts

130 120 110 100 90 80 70 60 50 40 30 20 10 0 10 20 30 40 50 60 70 80 90 100 110 120

4/4/03