

DATUM ELEV = 145.00

DATUM ELEV = 145.00

DATUM ELEV = 145.00

DATUM ELEV = 145.00


STA. 405+24, 48.5' LT.
BUILD NEW 48" DIA. C.B.
T.G. 150.60
INV. 144.06 18" OPTION PIPE, S IN
144.06 18" OPTION PIPE, N OUT
143.84

STA. 405+55, 32' LT.
BUILD NEW 48" M.H.
T.C. 150.91
INV. 144.23 12" PIPE, S IN
INV. 144.23 12" PIPE, N OUT

NEW 8" D.I. CROSSING (W/VALVE)
IN 16" STEEL SLEEVE (OPEN CUT)
@ STA 405+51±

CONSTRUCT GREEN MOUNTAIN DR.
STA 405+96.25 = 390+00.00

STA. 405+82.5--428+86 RT
EXIST. 6" X TRU GAS TO BE RETIRED IN PLACE

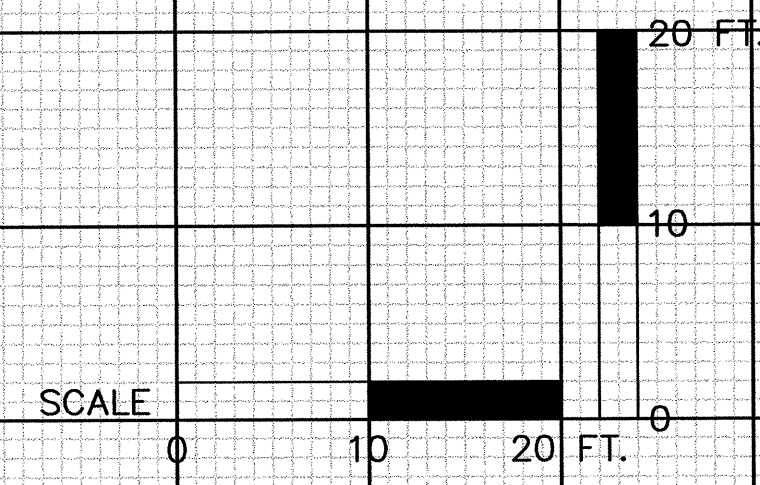

ERDMAN ANTHONY
CONSULTING ENGINEERS
Rochester, New York Camp Hill, Pennsylvania
Boston, Massachusetts

130 120 110 100 90 80 70 60 50 40 30 20 10 0 10 20 30 40 50 60 70 80 90 100 110 120

AS-BUILT REVISIONS		REVISED SEWER DESIGN
NO.	DATE	DESCRIPTION
1.	8/29/06	CHANGES MADE PER AS-BUILTS MARK UPS

4/4/03

SHELburne - SOUTH BURLINGTON
STA. 404+48 TO STA. 405+95
SURVEYED BY: V.S.C. INC. DATE: _____
DRAWN BY: E.A.A. INC. DATE: _____
TRACED BY: E.A.A. INC. DATE: _____
PROJECT: NH-EGC-019-4(28)
CROSS-SECTION DWG. NO. 106
SHEET 198R OF 283