

DATUM ELEV = 145.00

STA. 408+45, 44' LT.
BUILD NEW 48" DIA. C.B.
T.G. 149.74
INV. 143.20 18" OPTION PIPE, N IN
143.20 18" OPTION PIPE, S OUT

STA. 408+47.58

PROP. 12" WATER
STA. 408+45, 30' RT.
BUILD NEW 48" DIA. C.B.
T.G. 149.74
INV. 142.70 18" OPTION PIPE, N IN
142.70 18" OPTION PIPE, S OUT

STA. 408+52, 71' RT.
BUILD NEW END SECTION

DATUM ELEV = 145.00

STA. 407+99, 23.5' LT.
EXIST'G. DROP INLET
T.G. 152.44
INV. 147.26 IN 18" C.M.P.
INV. 147.25 IN 18" R.C.P.
INV. 147.25 OUT 18" R.C.P.

STA. 407+97.58

STA. 407+99, 23.5' RT.
EXIST'G. DROP INLET
T.G. 152.44
INV. 147.77 18" C.M.P.

DATUM ELEV = 145.00


STA. 407+75, 44' LT.
BUILD NEW 48" DIA. C.B.
T.G. 149.55
INV. 142.83 18" OPTION PIPE, N IN
142.83 18" OPTION PIPE, S OUT

STA. 407+47.58

STA. 407+75, 30' RT.
BUILD NEW 48" DIA. C.B.
T.G. 149.55
INV. 142.32 18" OPTION PIPE, N IN
142.32 18" OPTION PIPE, S OUT

DATUM ELEV = 145.00

STA. 407+37.58

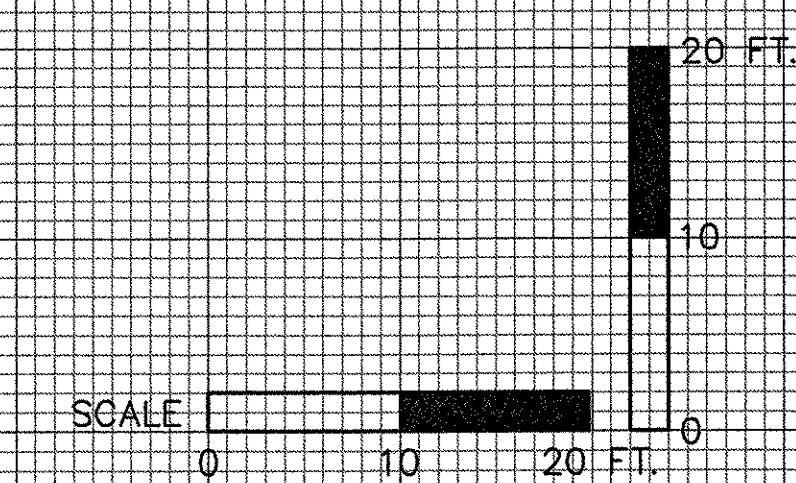

SHELBURNE - SOUTH BURLINGTON

STA. 407+38 TO STA. 408+48

SURVEYED BY V.S.C. INC. DATE

DRAWN BY E.A.A. INC. DATE

TRACED BY E.A.A. INC. DATE

PROJECT NH-EGC-019-4(28)

CROSS-SECTION DWG. NO. 108

SHEET 200 OF 283

