

DATUM ELEV = 145.00

DATUM ELEV = 145.00

DATUM ELEV = 145.00


DATUM ELEV = 145.00

STA. 409+54.58

STA. 409+47.58

STA. 408+97.58

STA. 408+77.58

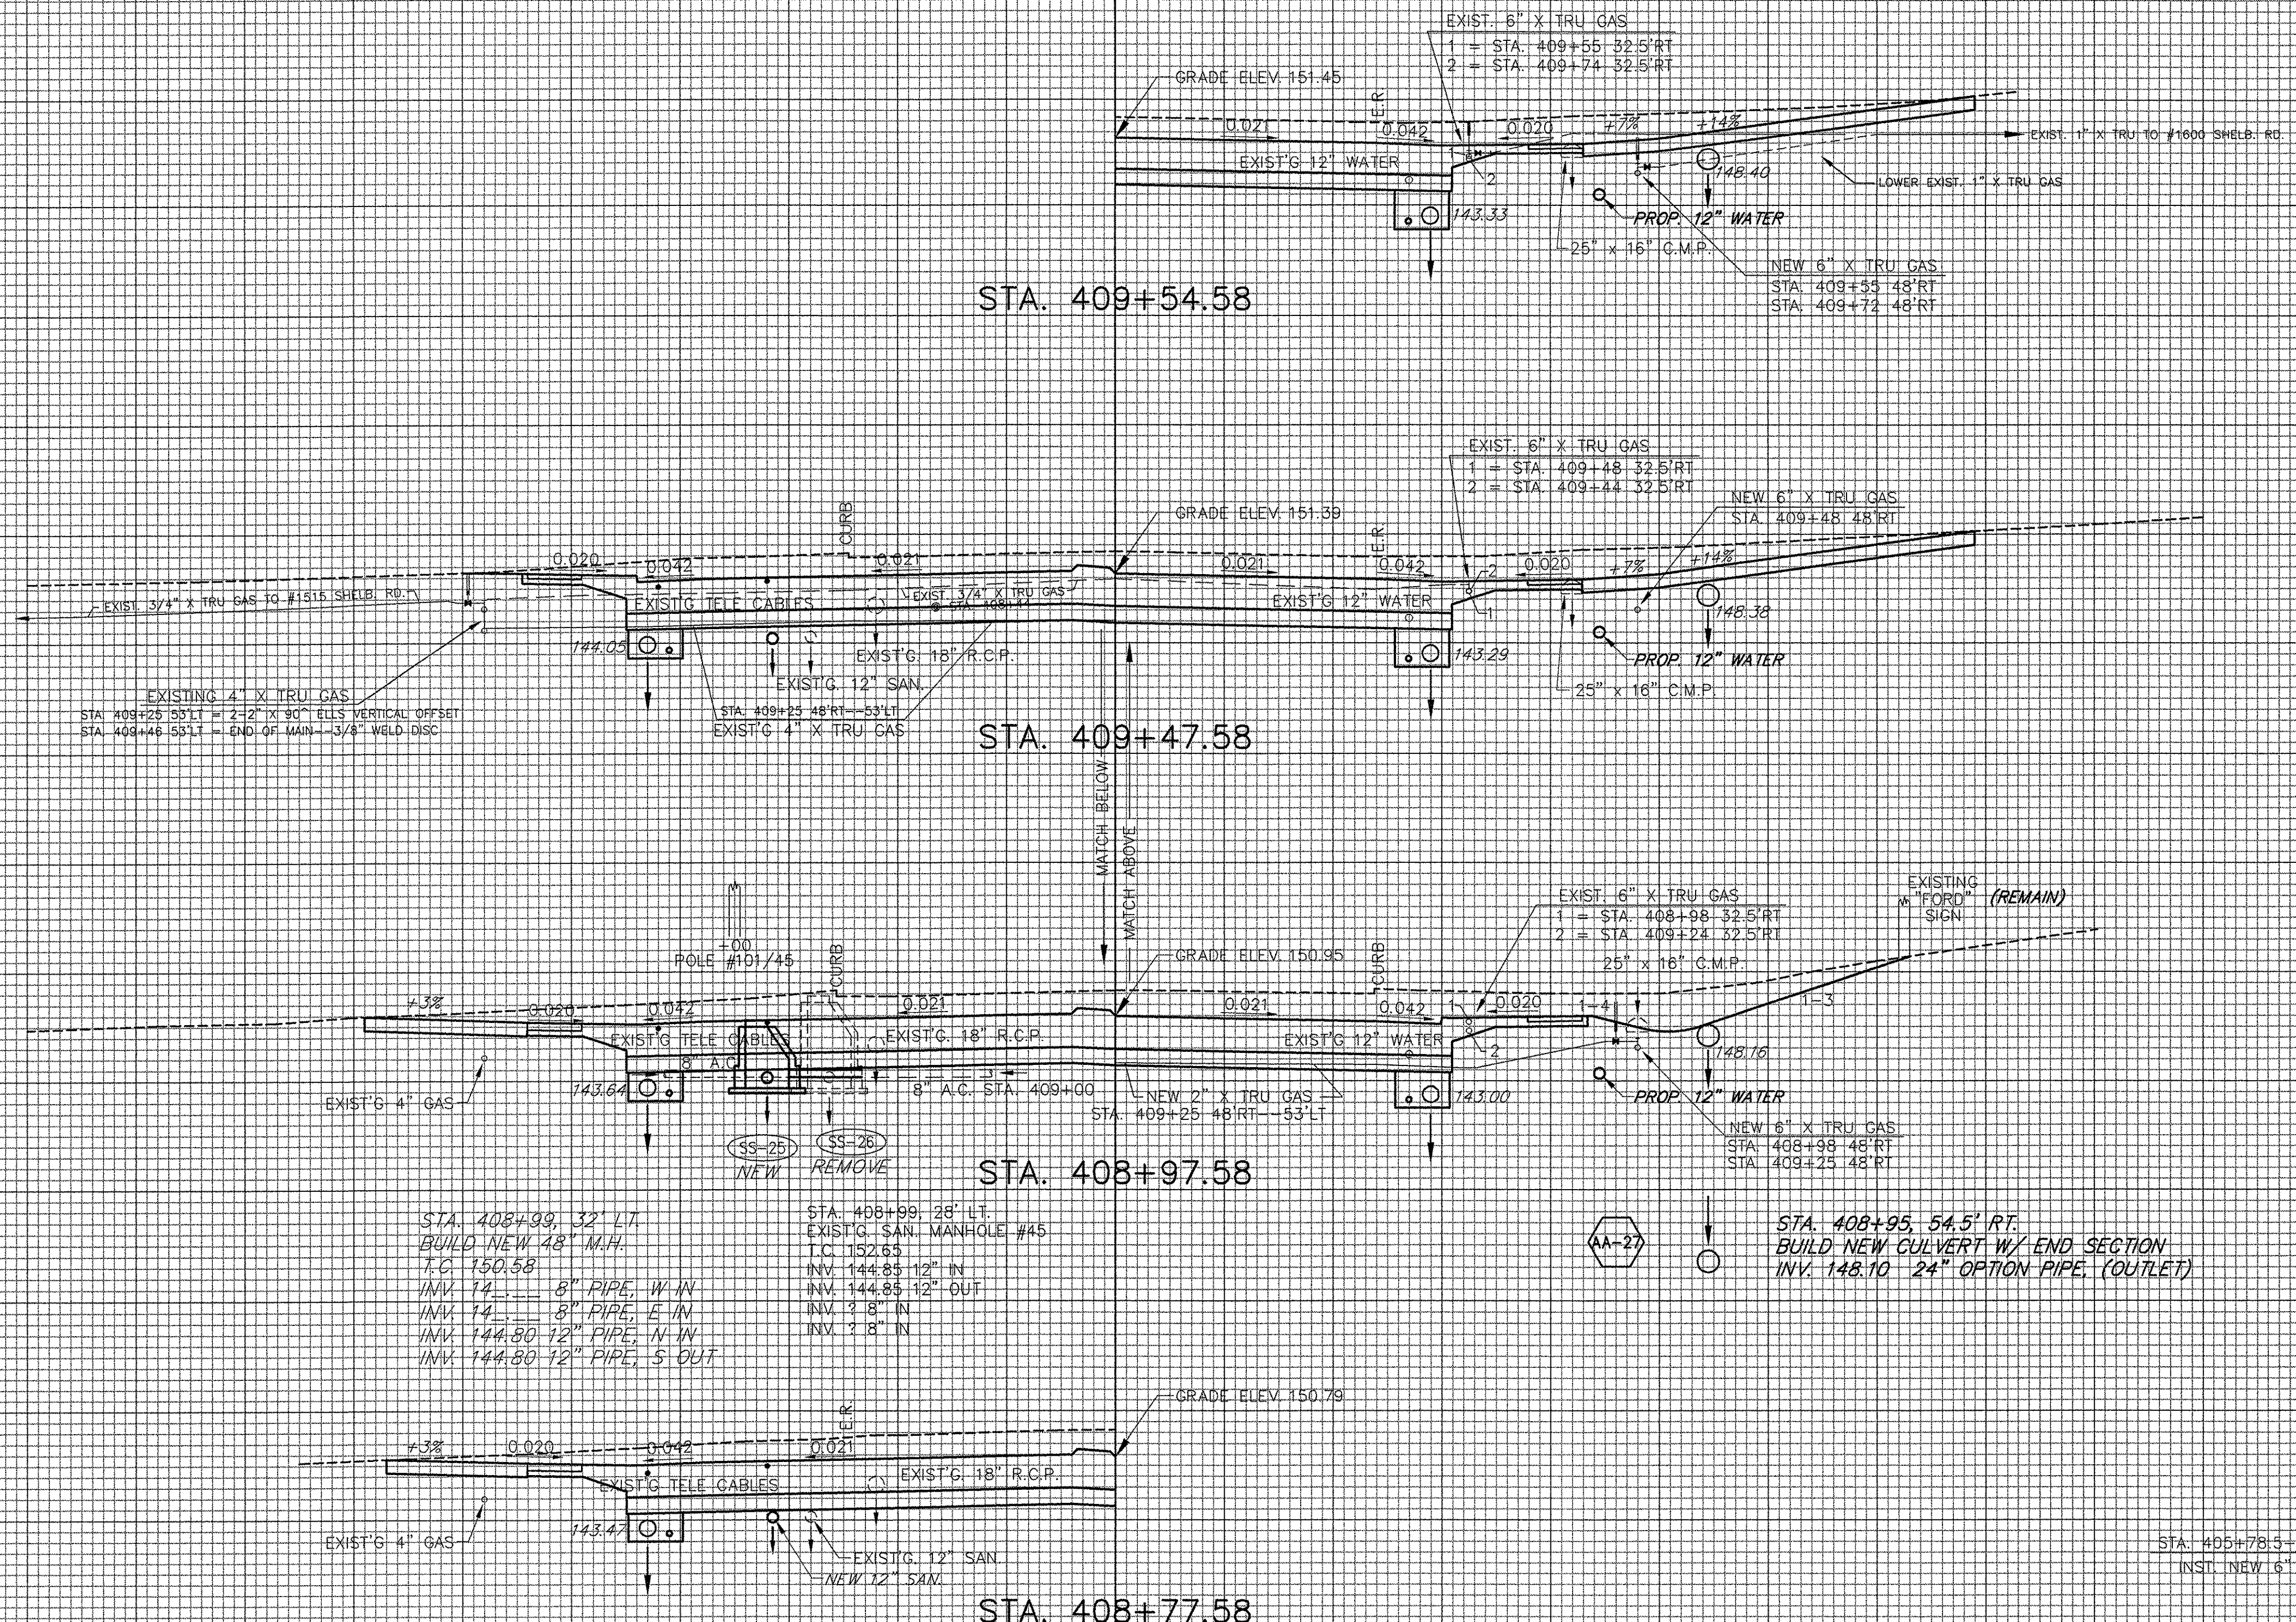

STA. 408+99, 32' LT.
 BUILD NEW 48" M.H.
 I.C. 150.58
 INV. 14' --- 8" PIPE, W-IN
 INV. 14' --- 8" PIPE, E-IN
 INV. 144.80 12" PIPE, N-IN
 INV. 144.80 12" PIPE, S-OUT

STA. 408+99, 28' LT.
 EXIST'G SAN MANHOLE #45
 T.C. 152.63
 INV. 144.85 12" IN
 INV. 144.85 12" OUT
 INV. 9' 8" IN
 INV. 9' 8" IN

STA. 408+95, 54.5' RT.
 BUILD NEW CULVERT W/ END SECTION
 INV. 148.10 24" TRU GAS (OUTLET)

STA. 405+B2.5 --- #28+85 RT
 EXIST. 6" X TRU GAS TO BE RETIRED IN PLACE

