


STA. 411+90, 54' RT.  
 BUILD NEW CULVERT W/ END SECTION  
 INV. 149.50 24" OPTION PIPE, (OUTLET)

STA. 405+78.5 = 416+25 RT  
 INST. NEW 6" X TRU GAS

STA. 405+82.5 = 428+86 RT  
 EXIST. 6" X TRU GAS TO BE RETIRED IN PLACE

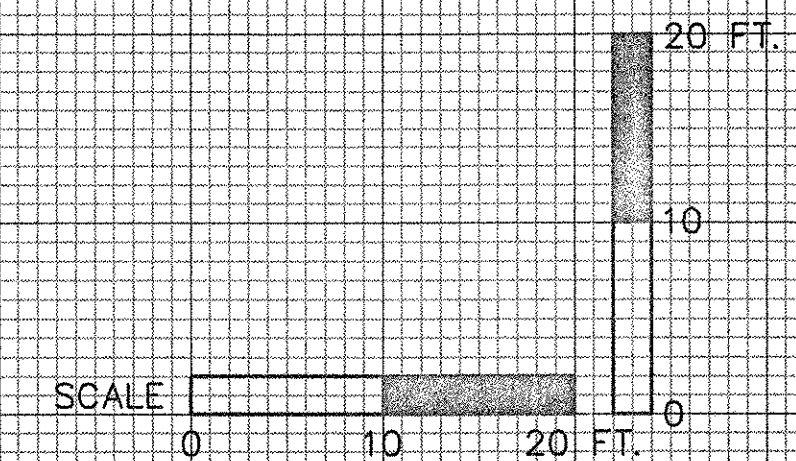

SHELBURNE - SOUTH BURLINGTON  
 STA. 410+98 TO STA. 412+26  
 SURVEYED BY V.S.C. INC. DATE \_\_\_\_\_  
 DRAWN BY E.A.A. INC. DATE \_\_\_\_\_  
 TRACED BY E.A.A. INC. DATE \_\_\_\_\_  
 PROJECT NH-EGC-019-4(28)  
 CROSS-SECTION DWG. NO. 111  
 SHEET 203 OF 283