


DATUM ELEV = 150.00

DATUM ELEV = 145.00

DATUM ELEV = 145.00

DATUM ELEV = 145.00

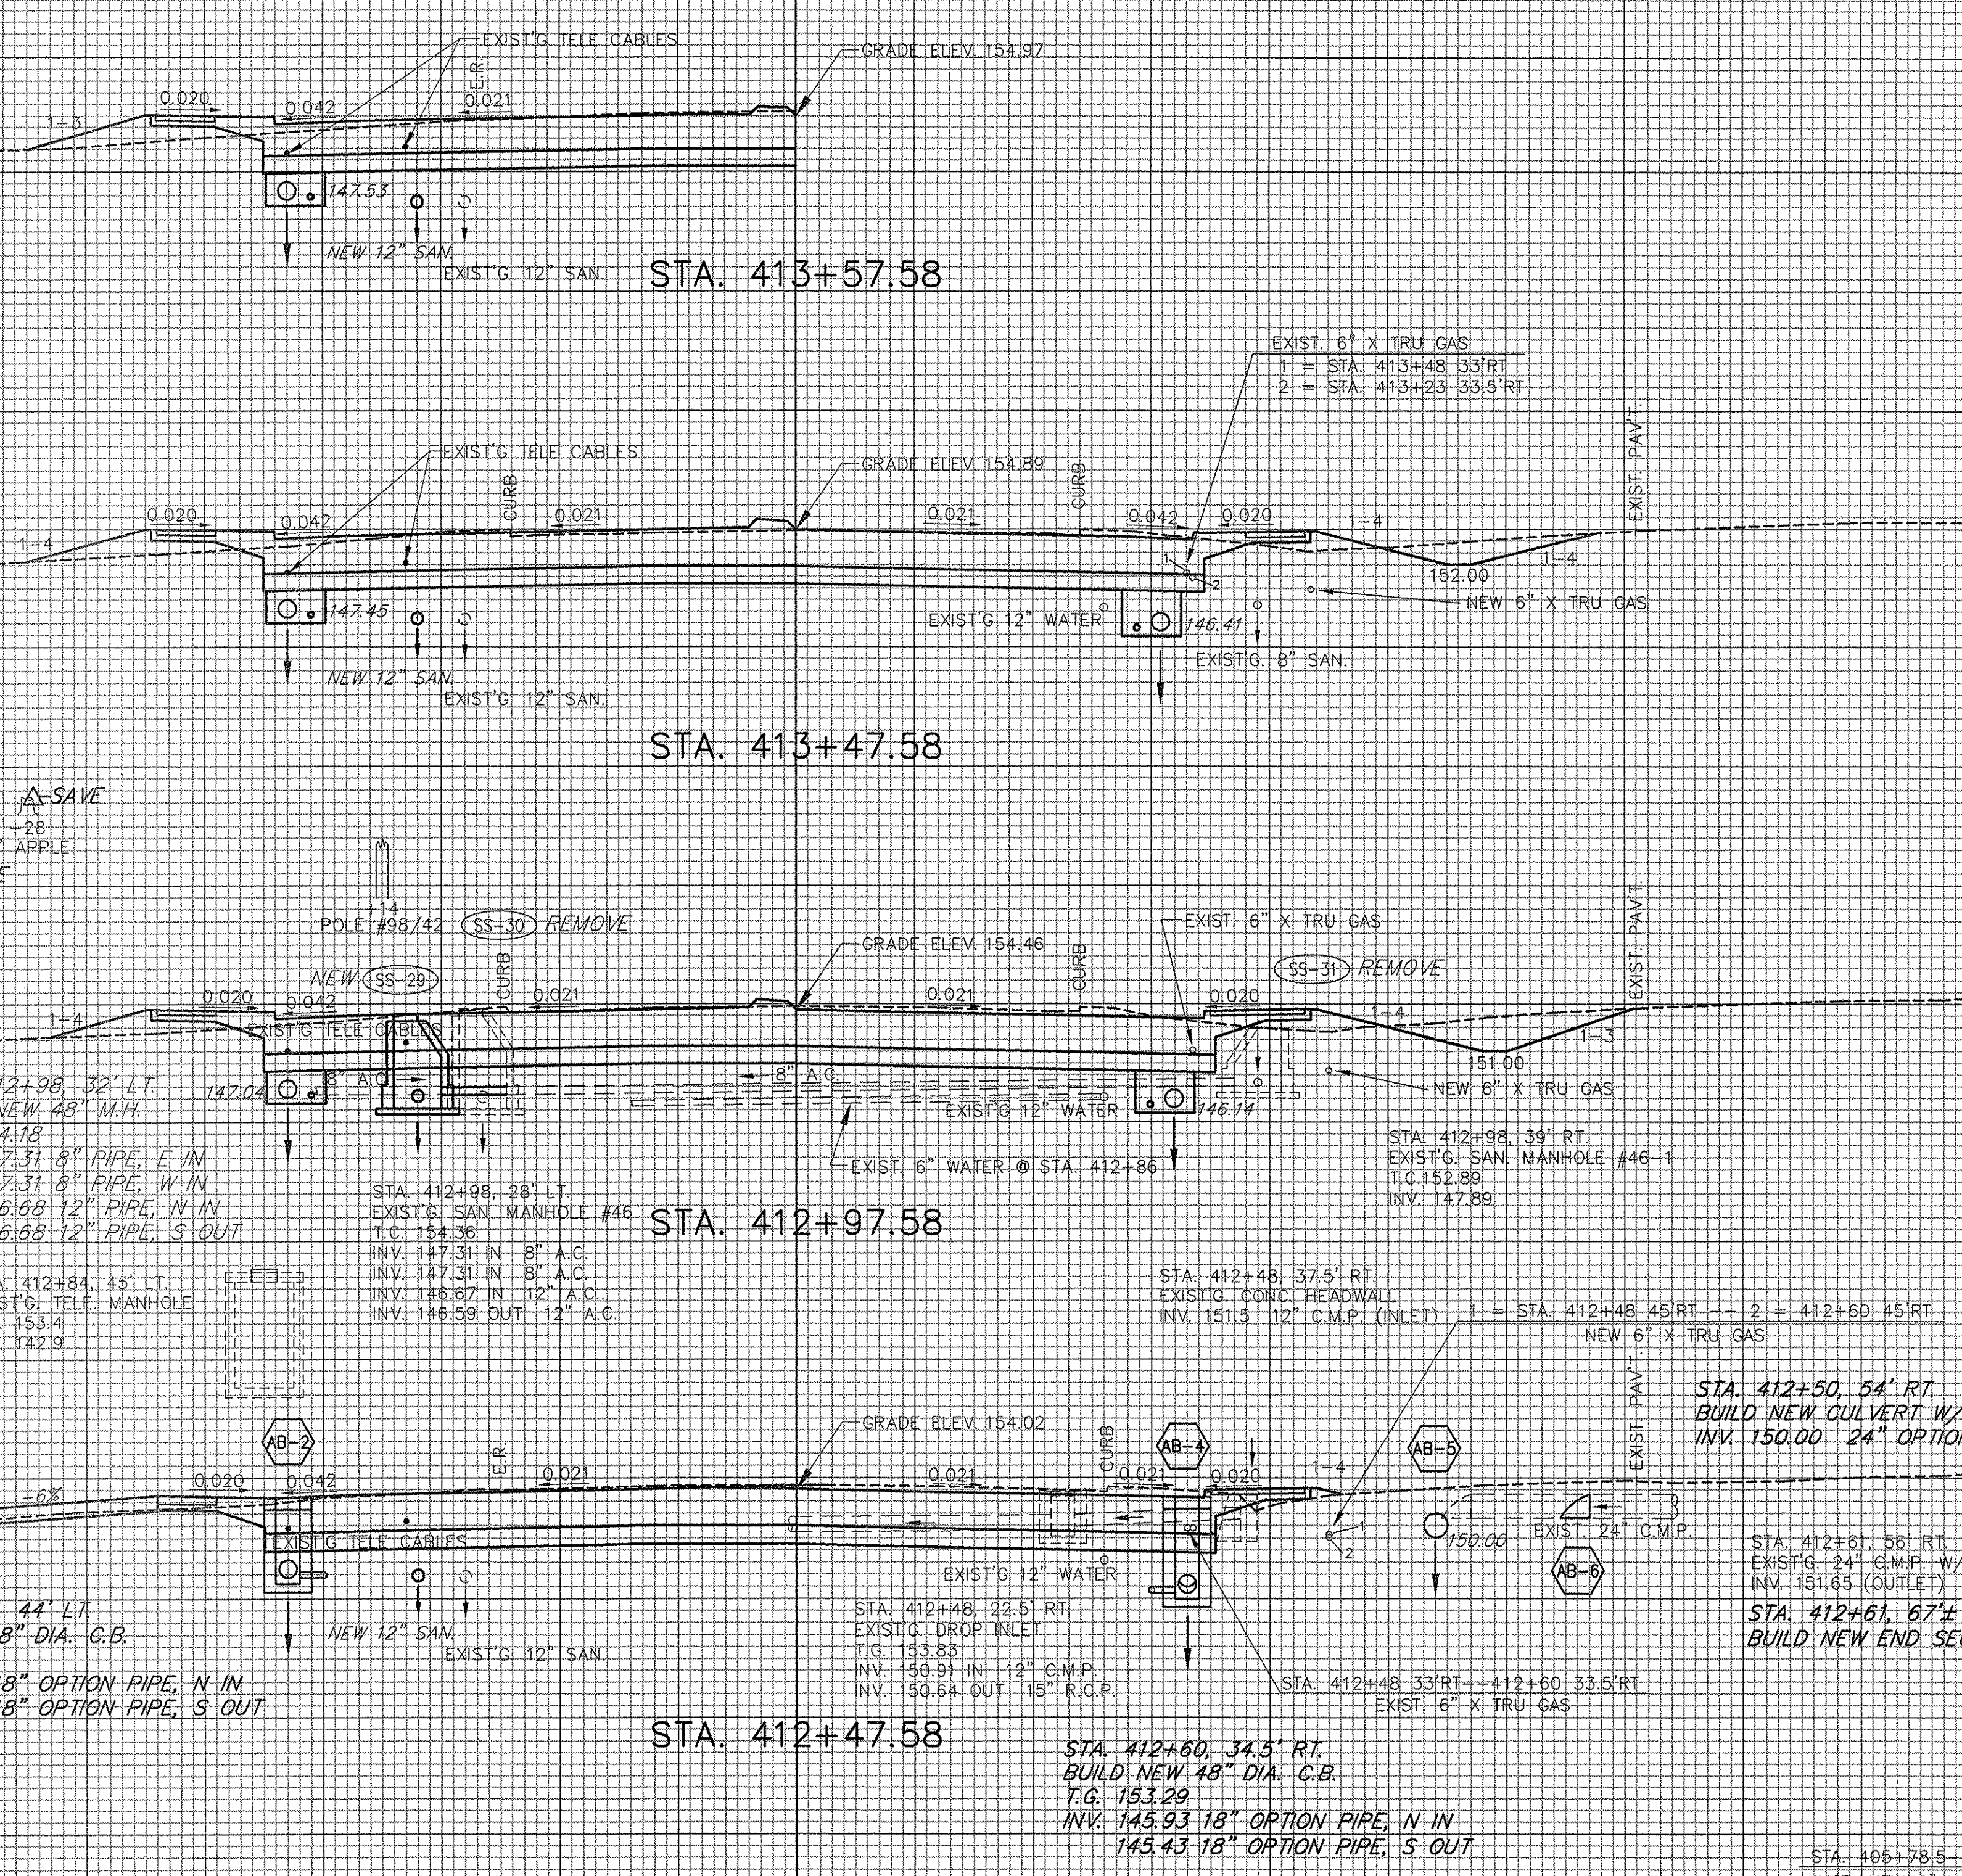

A-SAVE  
 37  
 8" APPLE  
 A-SAVE  
 28  
 8" APPLE  
 A-SAVE  
 23  
 8" APPLE  
 A-SAVE  
 14  
 8" APPLE

STA. 412+98, 32' LT.  
 BUILD NEW 48" M.H.  
 T.C. 154.18  
 INV. 147.31 8" PIPE, E IN  
 INV. 147.31 8" PIPE, W IN  
 INV. 146.68 12" PIPE, N IN  
 INV. 146.68 12" PIPE, S OUT

STA. 412+84, 45' LT.  
 EXIST'G TELE MANHOLE  
 T.C. 153.74  
 INV. 142.9

STA. 412+98, 28' LT.  
 EXIST'G SAN. MANHOLE #46  
 T.C. 154.36  
 INV. 147.31 IN 8" A.C.  
 INV. 147.31 IN 8" A.C.  
 INV. 146.67 IN 12" A.C.  
 INV. 146.69 OUT 12" A.C.

STA. 412+48, 37.5' RT.  
 EXIST'G CONC. HEADWALL  
 INV. 151.5 12" C.M.P. (INLET) 1 = STA. 412+48 45' RT. 2 = 412+60 45' RT.  
 NEW 6" X TRU GAS

STA. 412+50, 54' RT.  
 BUILD NEW CULVERT W/ END SECTION  
 INV. 150.00 24" OPTION PIPE, (INLET)

STA. 412+61, 38' RT.  
 EXIST'G 24" C.M.P. W/END SECTION  
 INV. 151.65 (OUTLET)

STA. 412+61, 67' RT.  
 BUILD NEW END SECTION

STA. 412+60, 34.5' RT.  
 BUILD NEW 48" DIA. C.B.  
 T.C. 153.29  
 INV. 145.93 18" OPTION PIPE, N IN  
 INV. 145.43 18" OPTION PIPE, S OUT

STA. 405+78.5 - 416+00 RT.  
 INST. NEW 6" X TRU GAS

STA. 405+82.5 - 428+86 RT.  
 EXIST. 6" X TRU GAS TO BE RETIRED IN PLACE

