

DATUM ELEV = 150.00

DATUM ELEV = 150.00

DATUM ELEV = 150.00

DATUM ELEV = 150.00

STA. 417+65.58

STA. 417+47.58

STA. 417+37.58

STA. 416+97.58

STA. 417+70.46 RT.  
EXIST'G. 42" R.C.P. & CONC. HEADWALL  
INV. 151.94 (INLET)

STA. 417+78.73 RT.  
EXIST'G. 24" P.V.C.  
INV. 152.47 (OUTLET)

STA. 417+77.49 RT.  
EXIST'G. 15" C.M.P.  
INV. 152.61 (OUTLET)

STA. 417+79.73 RT.  
BUILD NEW 30"x30" D.I.  
T.G. 155.90  
INV. 152.33 EXISTING 12" C.M.P. E IN  
152.33 24" P.V.C. N IN  
151.83 24" OPTION PIPE, W OUT

STA. 417+36.30 RT.  
BUILD NEW 72" DIA. C.B.  
T.G. 157.69  
INV. 149.83 24" OPTION PIPE, E IN  
150.33 18" OPTION PIPE, N IN  
149.33 24" OPTION PIPE, W OUT


STA. 417+09.32 LT.  
BUILD NEW 48" M.H.  
T.G. 157.74  
INV. 149.21 8" PIPE, E IN  
148.99 8" PIPE, W IN  
148.26 12" PIPE, N IN  
148.26 12" PIPE, S OUT

STA. 417+09.28 LT.  
EXIST'G. SAN. MANHOLE #47  
T.C. 157.22  
INV. 149.21 IN 8" V.C.  
INV. 148.99 IN 8" V.C.  
INV. 148.37 IN 12" V.C.  
INV. 148.27 OUT 12" V.C.

STA. 416+09--417+35 RT.  
INST. NEW 21" DRISCO GAS

STA. 405+82.5--428+86 RT.  
EXIST'G. 6" X TRU GAS TO BE RETIRED IN PLACE

STA. 416+00--428+90 55' LT.  
INST. NEW 6" X TRU GAS

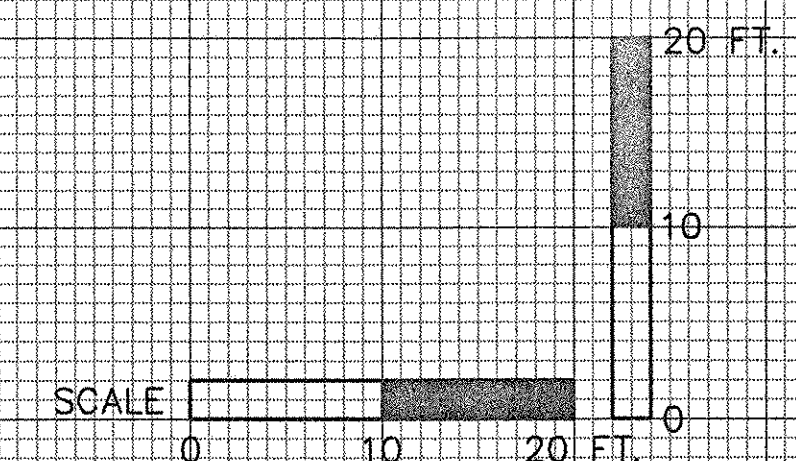

SHELBURNE -- SOUTH BURLINGTON

STA. 416+98 TO STA. 417+66

SURVEYED BY V.S.C. INC. DATE  
DRAWN BY E.A.A. INC. DATE  
TRACED BY E.A.A. INC. DATE

PROJECT NH-EGC-019-4(28)  
CROSS-SECTION DWG. NO. 115  
SHEET 207 OF 283

4/4/03