

DATUM ELEV = 170.00

DATUM ELEV = 170.00

DATUM ELEV = 170.00

DATUM ELEV = 170.00

EXIST'G. 6" X TRU GAS
BUS SHELTER
STA. 425+34.2 RT.

STA. 425+18: 87.5' RT.
EXIST'G. DROP INLET
T.G. 175.03
INV. 167.93 18" P.V.C. IN
167.84 18" P.V.C. OUT

STA. 425+14.58

STA. 425+08: 52' RT.
EXIST'G. SAN. MANHOLE #49-1
T.C. 176.47
INV. 169.42 IN
169.42 OUT 8" V.C.

STA. 424+97.58


STA. 424+80: 35' RT.
BUILD NEW 48" DIA. C.B.
T.G. 175.49
INV. 170.44 18" OPTION PIPE, N IN
168.94 18" OPTION PIPE, S OUT

STA. 424+78.58

STA. 424+47.58

STA. 424+40: 44' LT.
BUILD NEW 48" DIA. C.B.
T.G. 174.45
INV. 166.70 18" OPTION PIPE, SW IN
165.59 18" OPTION PIPE, N IN
165.59 18" OPTION PIPE, S OUT

STA. 424+28: 114' RT.
EXIST'G. DROP INLET
T.G. 173.99
INV. 166.71 18" P.V.C. IN
166.54 24" P.V.C. IN
166.53 24" P.V.C. OUT

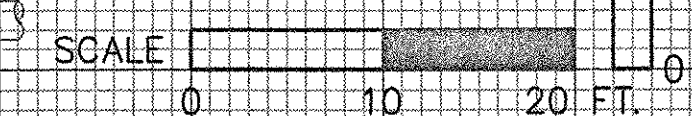

SHELBURNE -- SOUTH BURLINGTON

STA. 424+48 TO STA. 425+15

SURVEYED BY V.S.C. INC. DATE
DRAWN BY E.A.A. INC. DATE
TRACED BY E.A.A. INC. DATE

PROJECT NH-EGC-019-4(28)

CROSS-SECTION DWG. NO. 120

SHEET 212 OF 283