
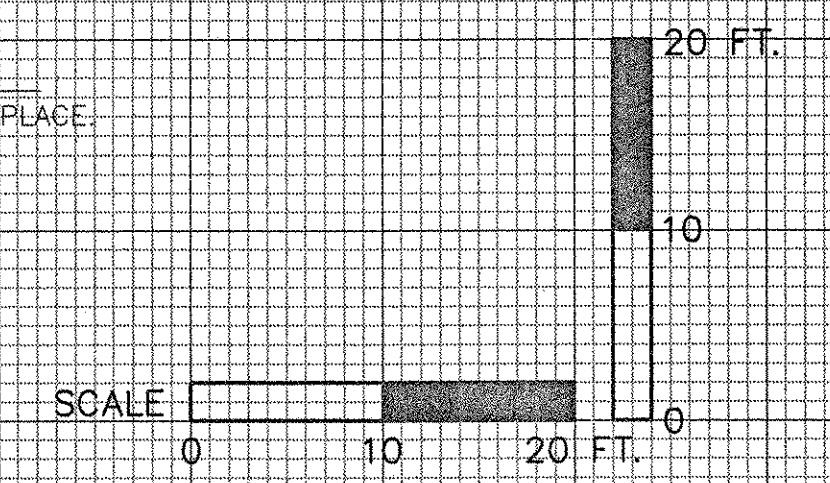


DATUM ELEV = 155.00

DATUM ELEV = 160.00

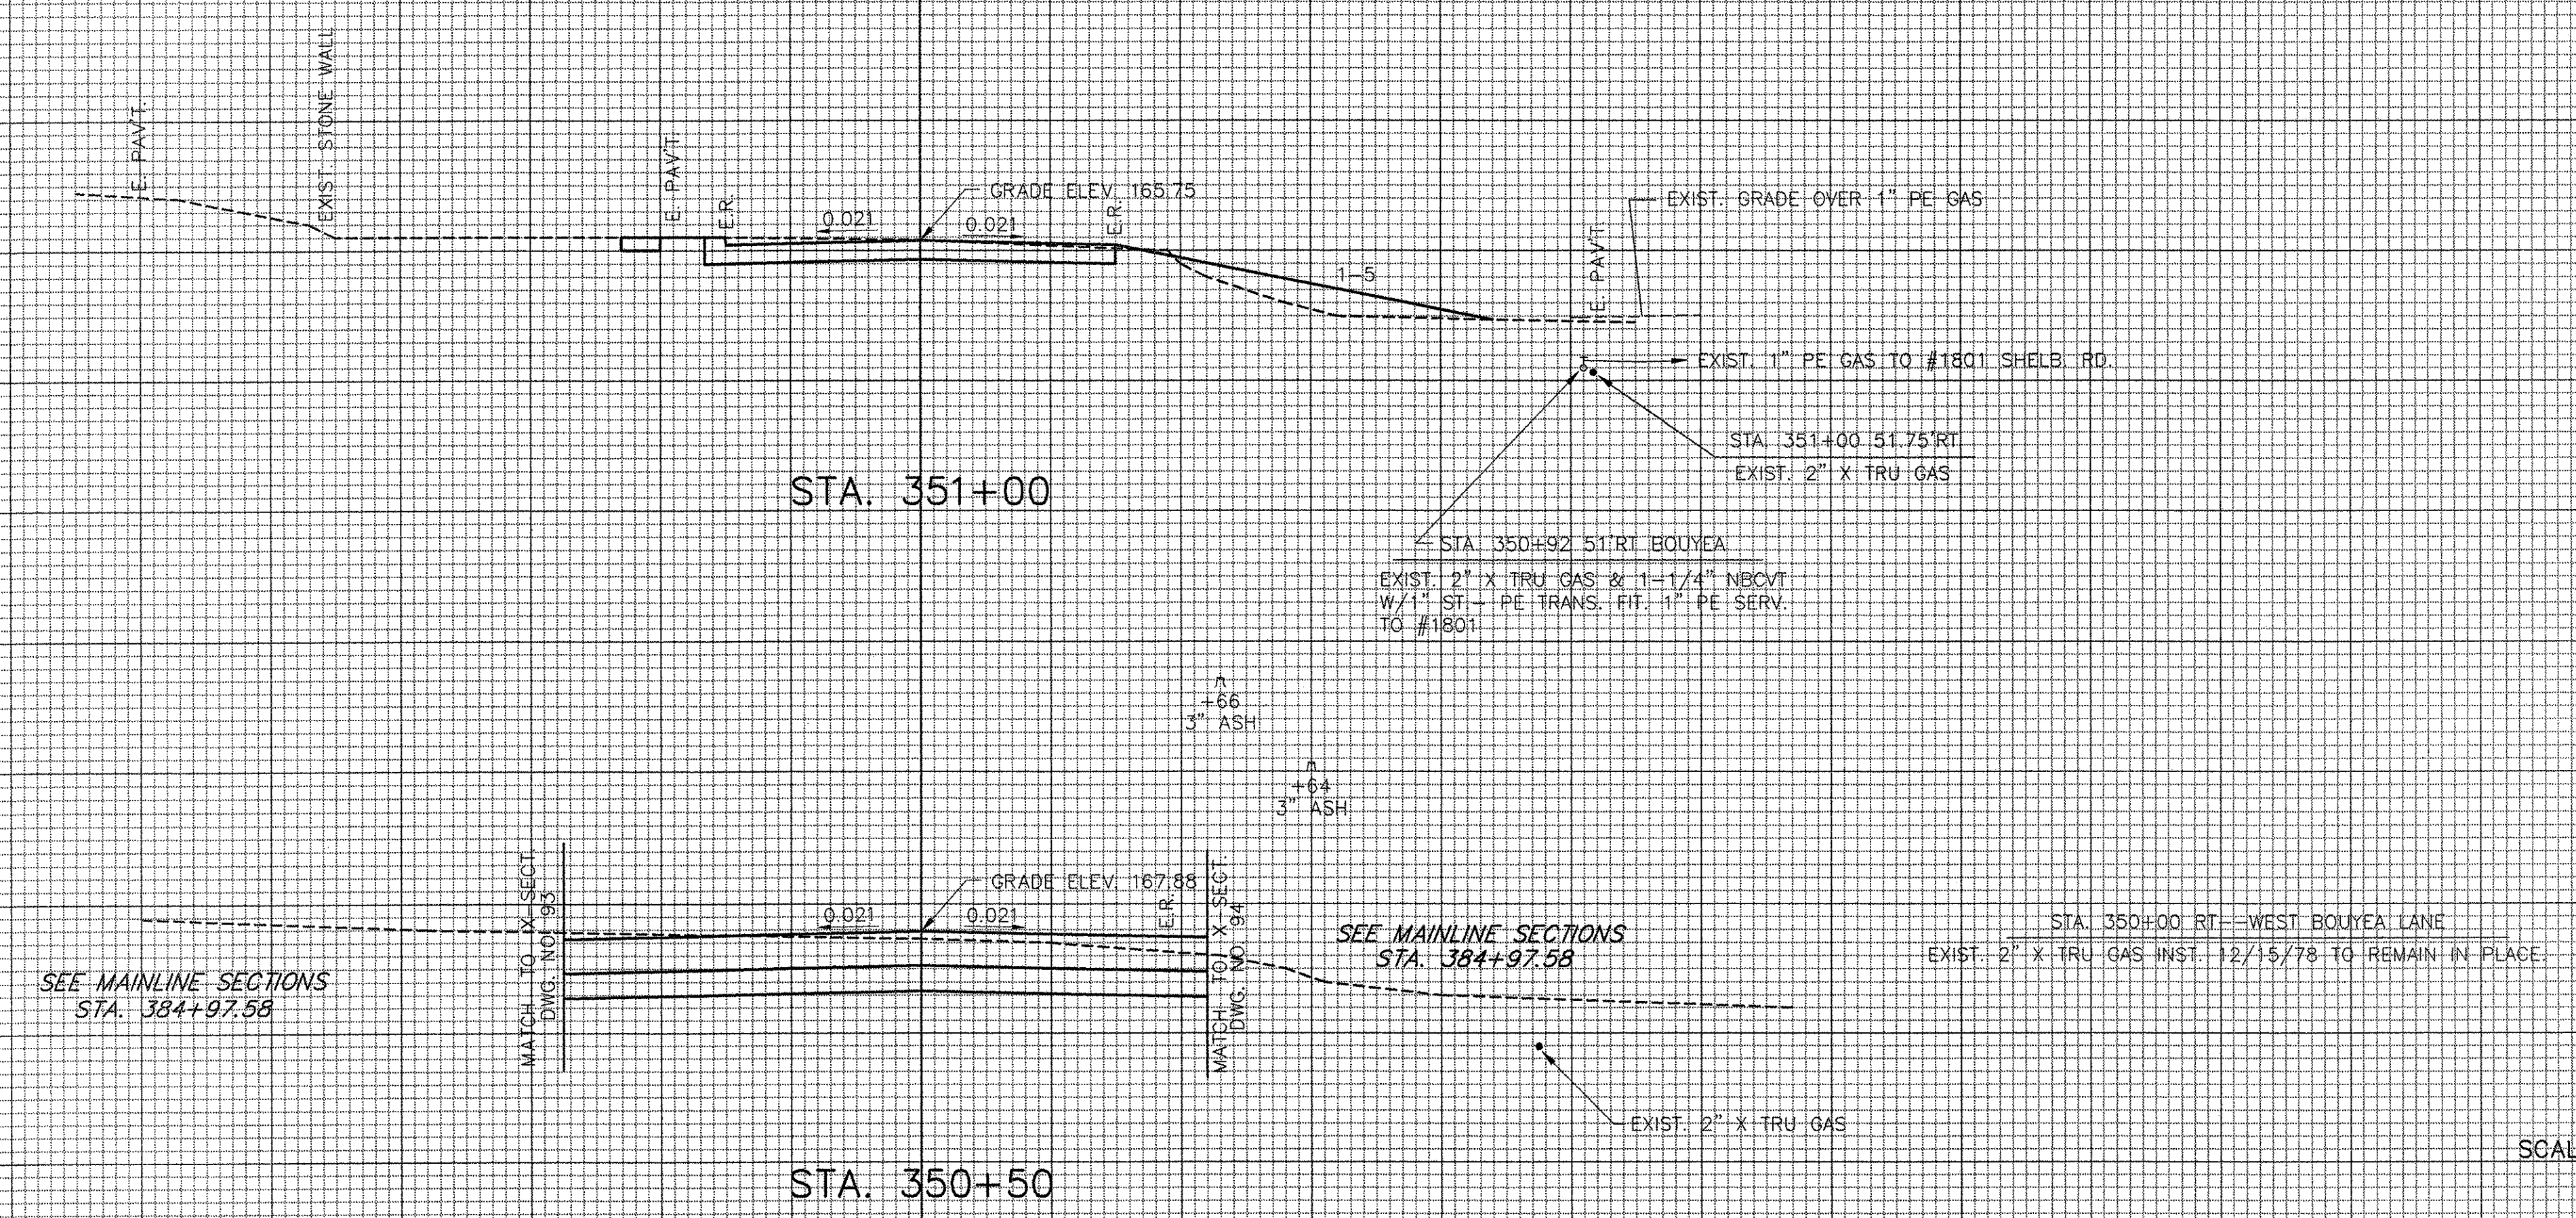

DRIVEWAY @ 385+30, LT.  
(BOUYEA LANE)

SHELBURNE - SOUTH BURLINGTON  
 STA. 350+50 TO STA. 351+00  
 SURVEYED BY V.S.C. INC. DATE \_\_\_\_\_  
 DRAWN BY E.A.A. INC. DATE \_\_\_\_\_  
 TRACED BY E.A.A. INC. DATE \_\_\_\_\_  
 PROJECT NH-EGC-019-4(28)  
 CROSS-SECTION DWG. NO. 145  
 SHEET 217 OF 283