
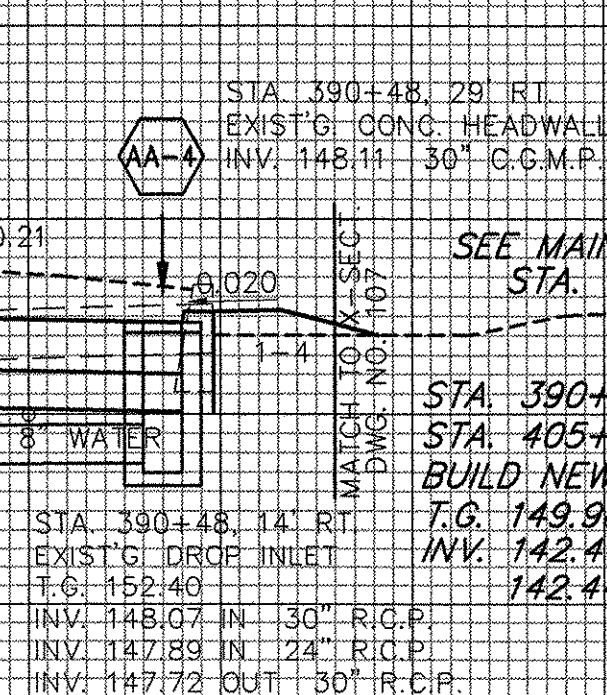
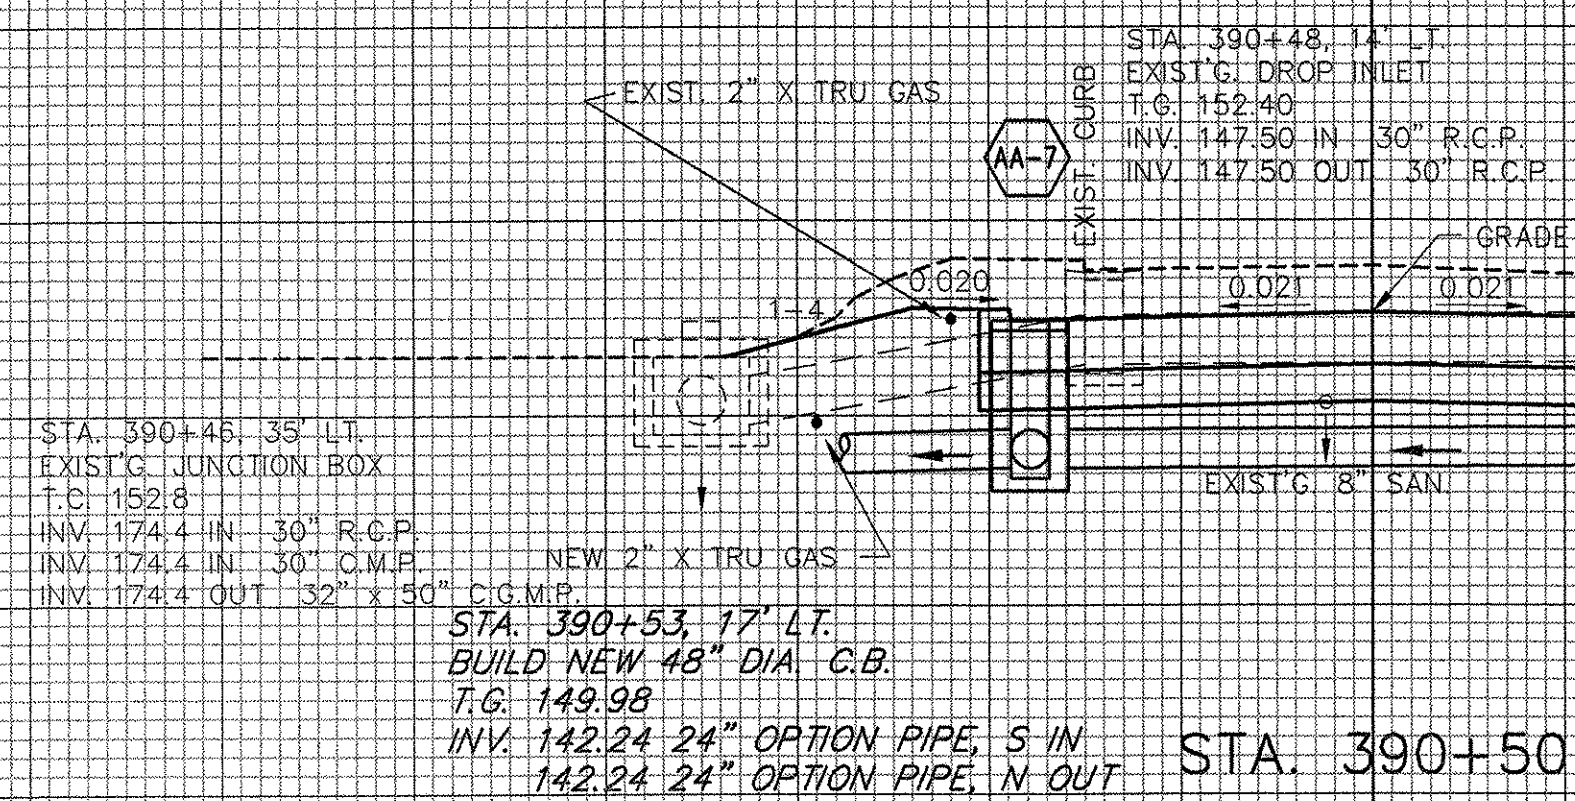
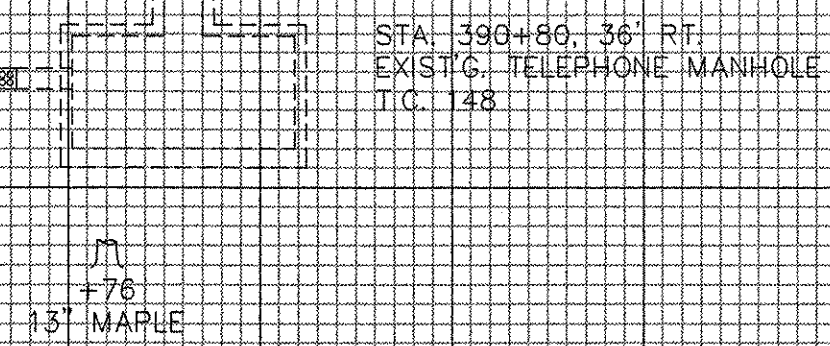
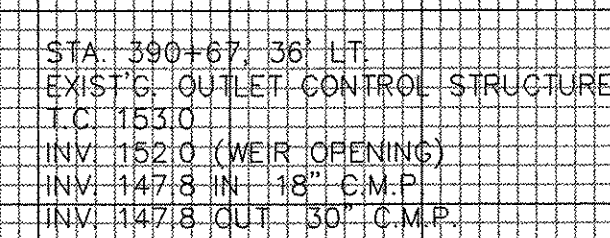
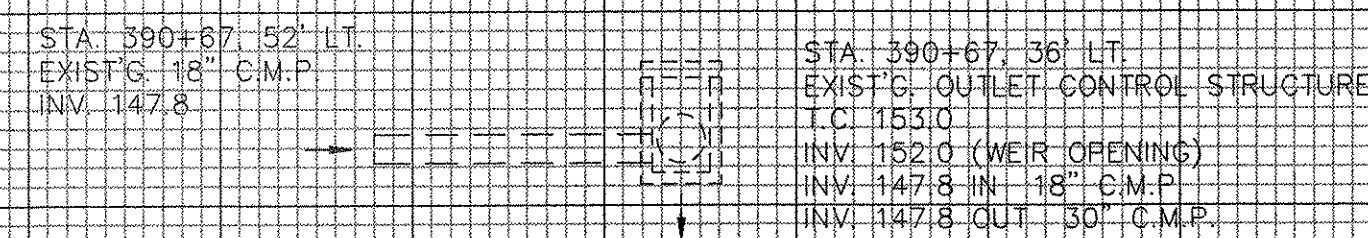
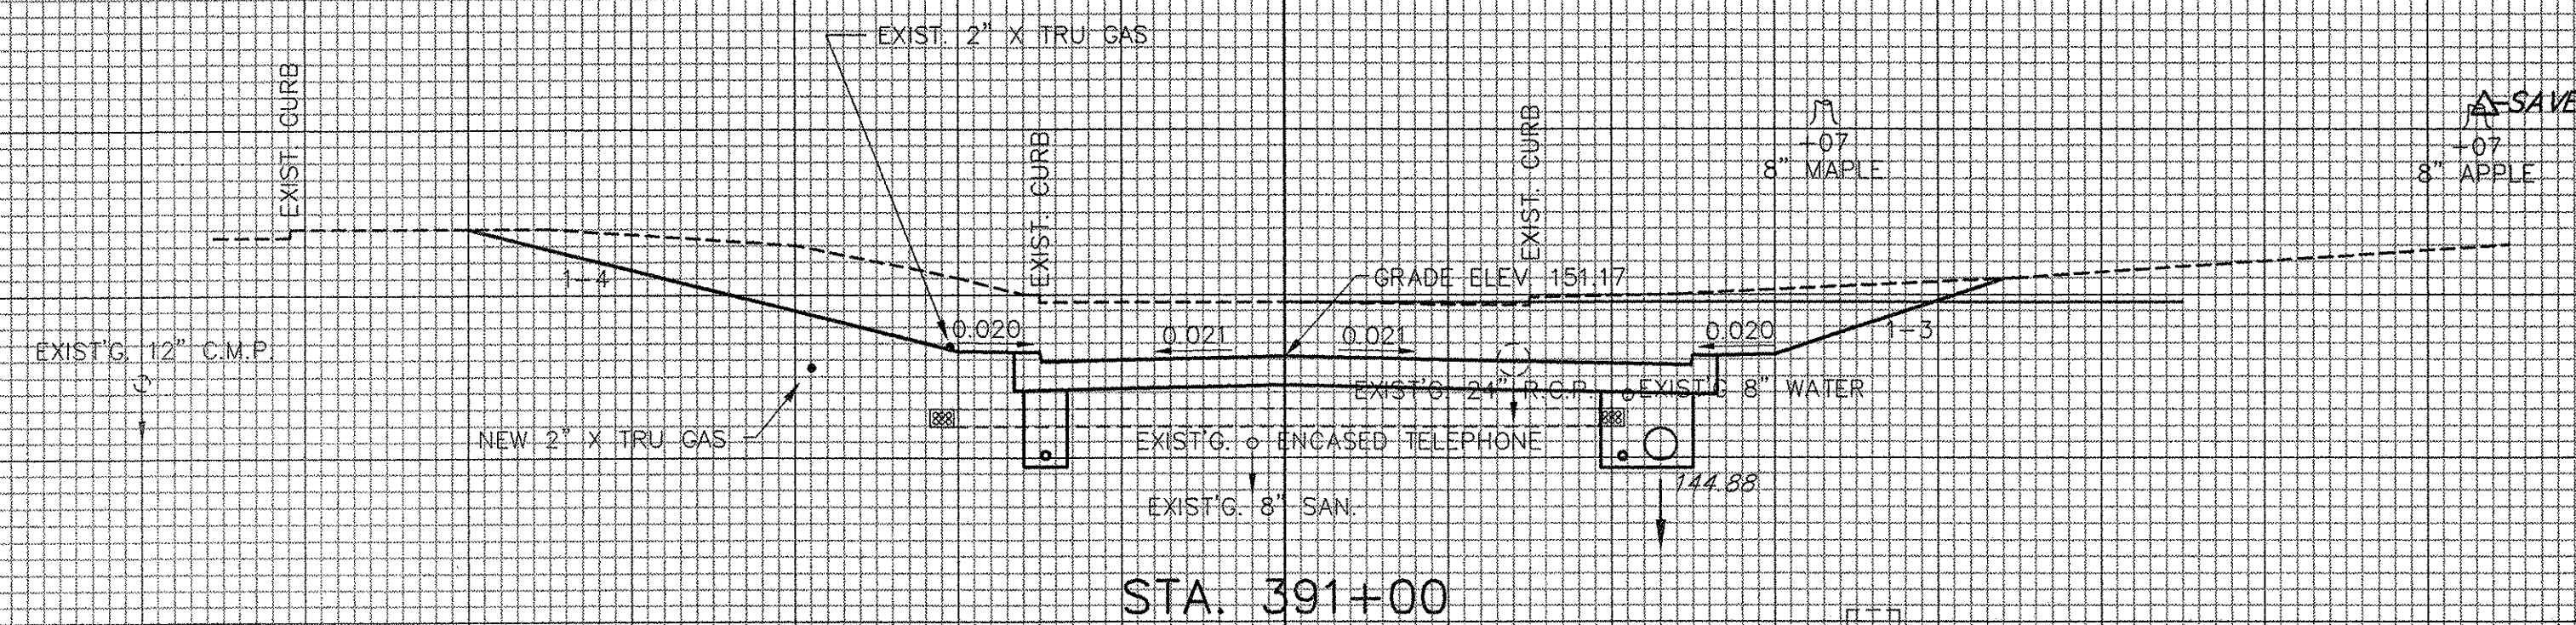


DATUM ELEV = 145.00

DATUM ELEV = 145.00

DATUM ELEV = 145.00

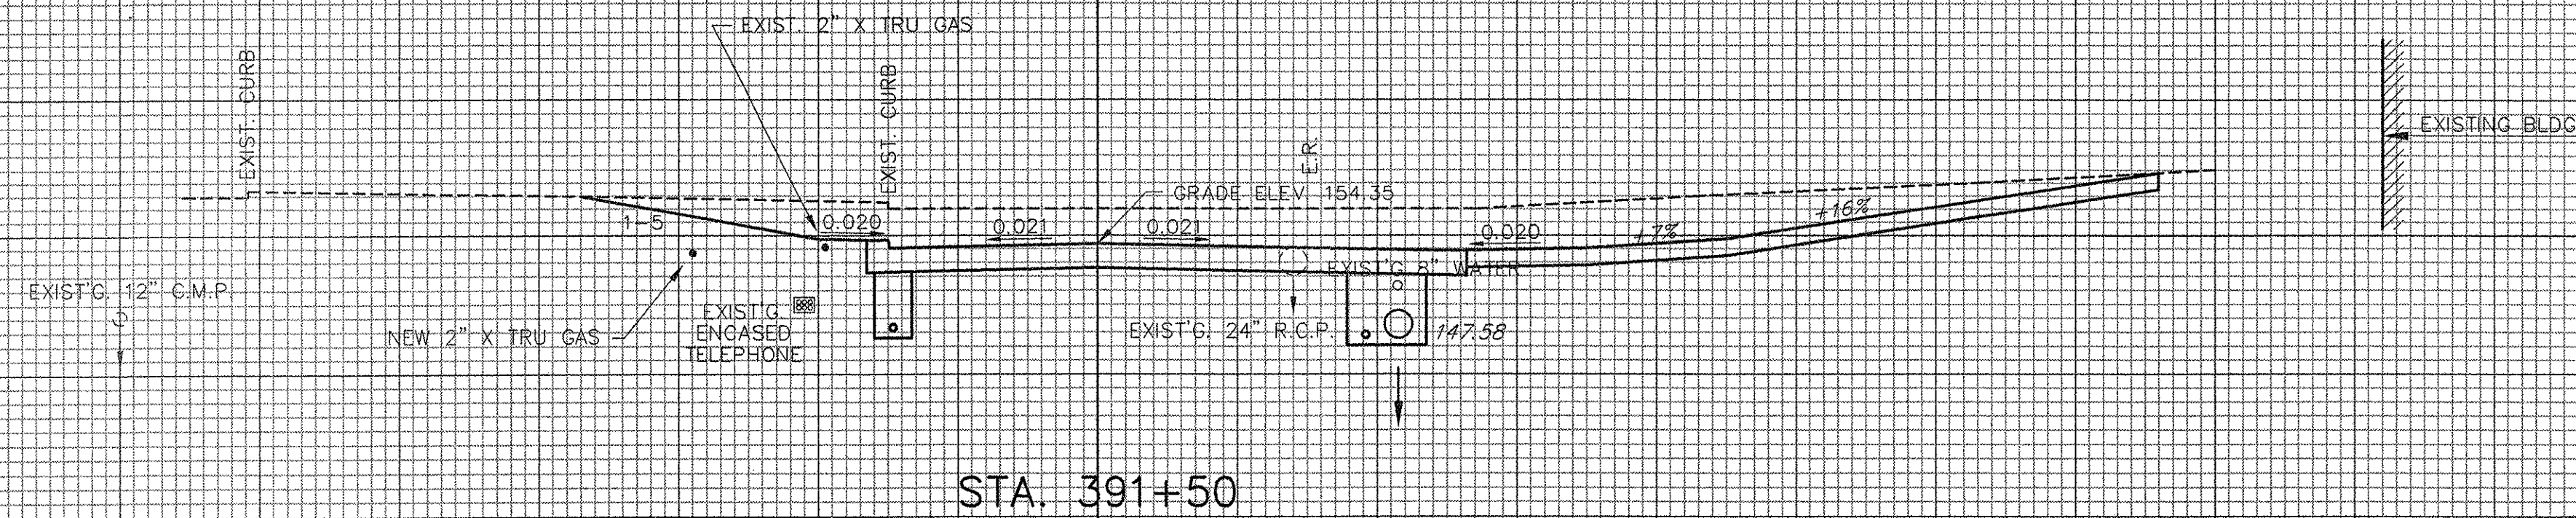

SEE MAINLINE SECTIONS STA. 405+97.58

STA. 390+53.25 RT. = STA. 405+70.53 RT. BUILD NEW 48\"/>

STA. 390+40.52 - 392+50 LT. GRN. MTN. INST. NEW 2\"/>

STA. 390+34.7 - 392+46 LT. GRN. MTN. EXIST. 2\"/>

STA. 390+53.17 LT. BUILD NEW 48\"/>

INV. 142.24 24\"/>

STA. 390+50

GREEN MOUNTAIN DRIVE

