


DATUM ELEV = 160.00

DATUM ELEV = 160.00

DATUM ELEV = 165.00

DATUM ELEV = 165.00

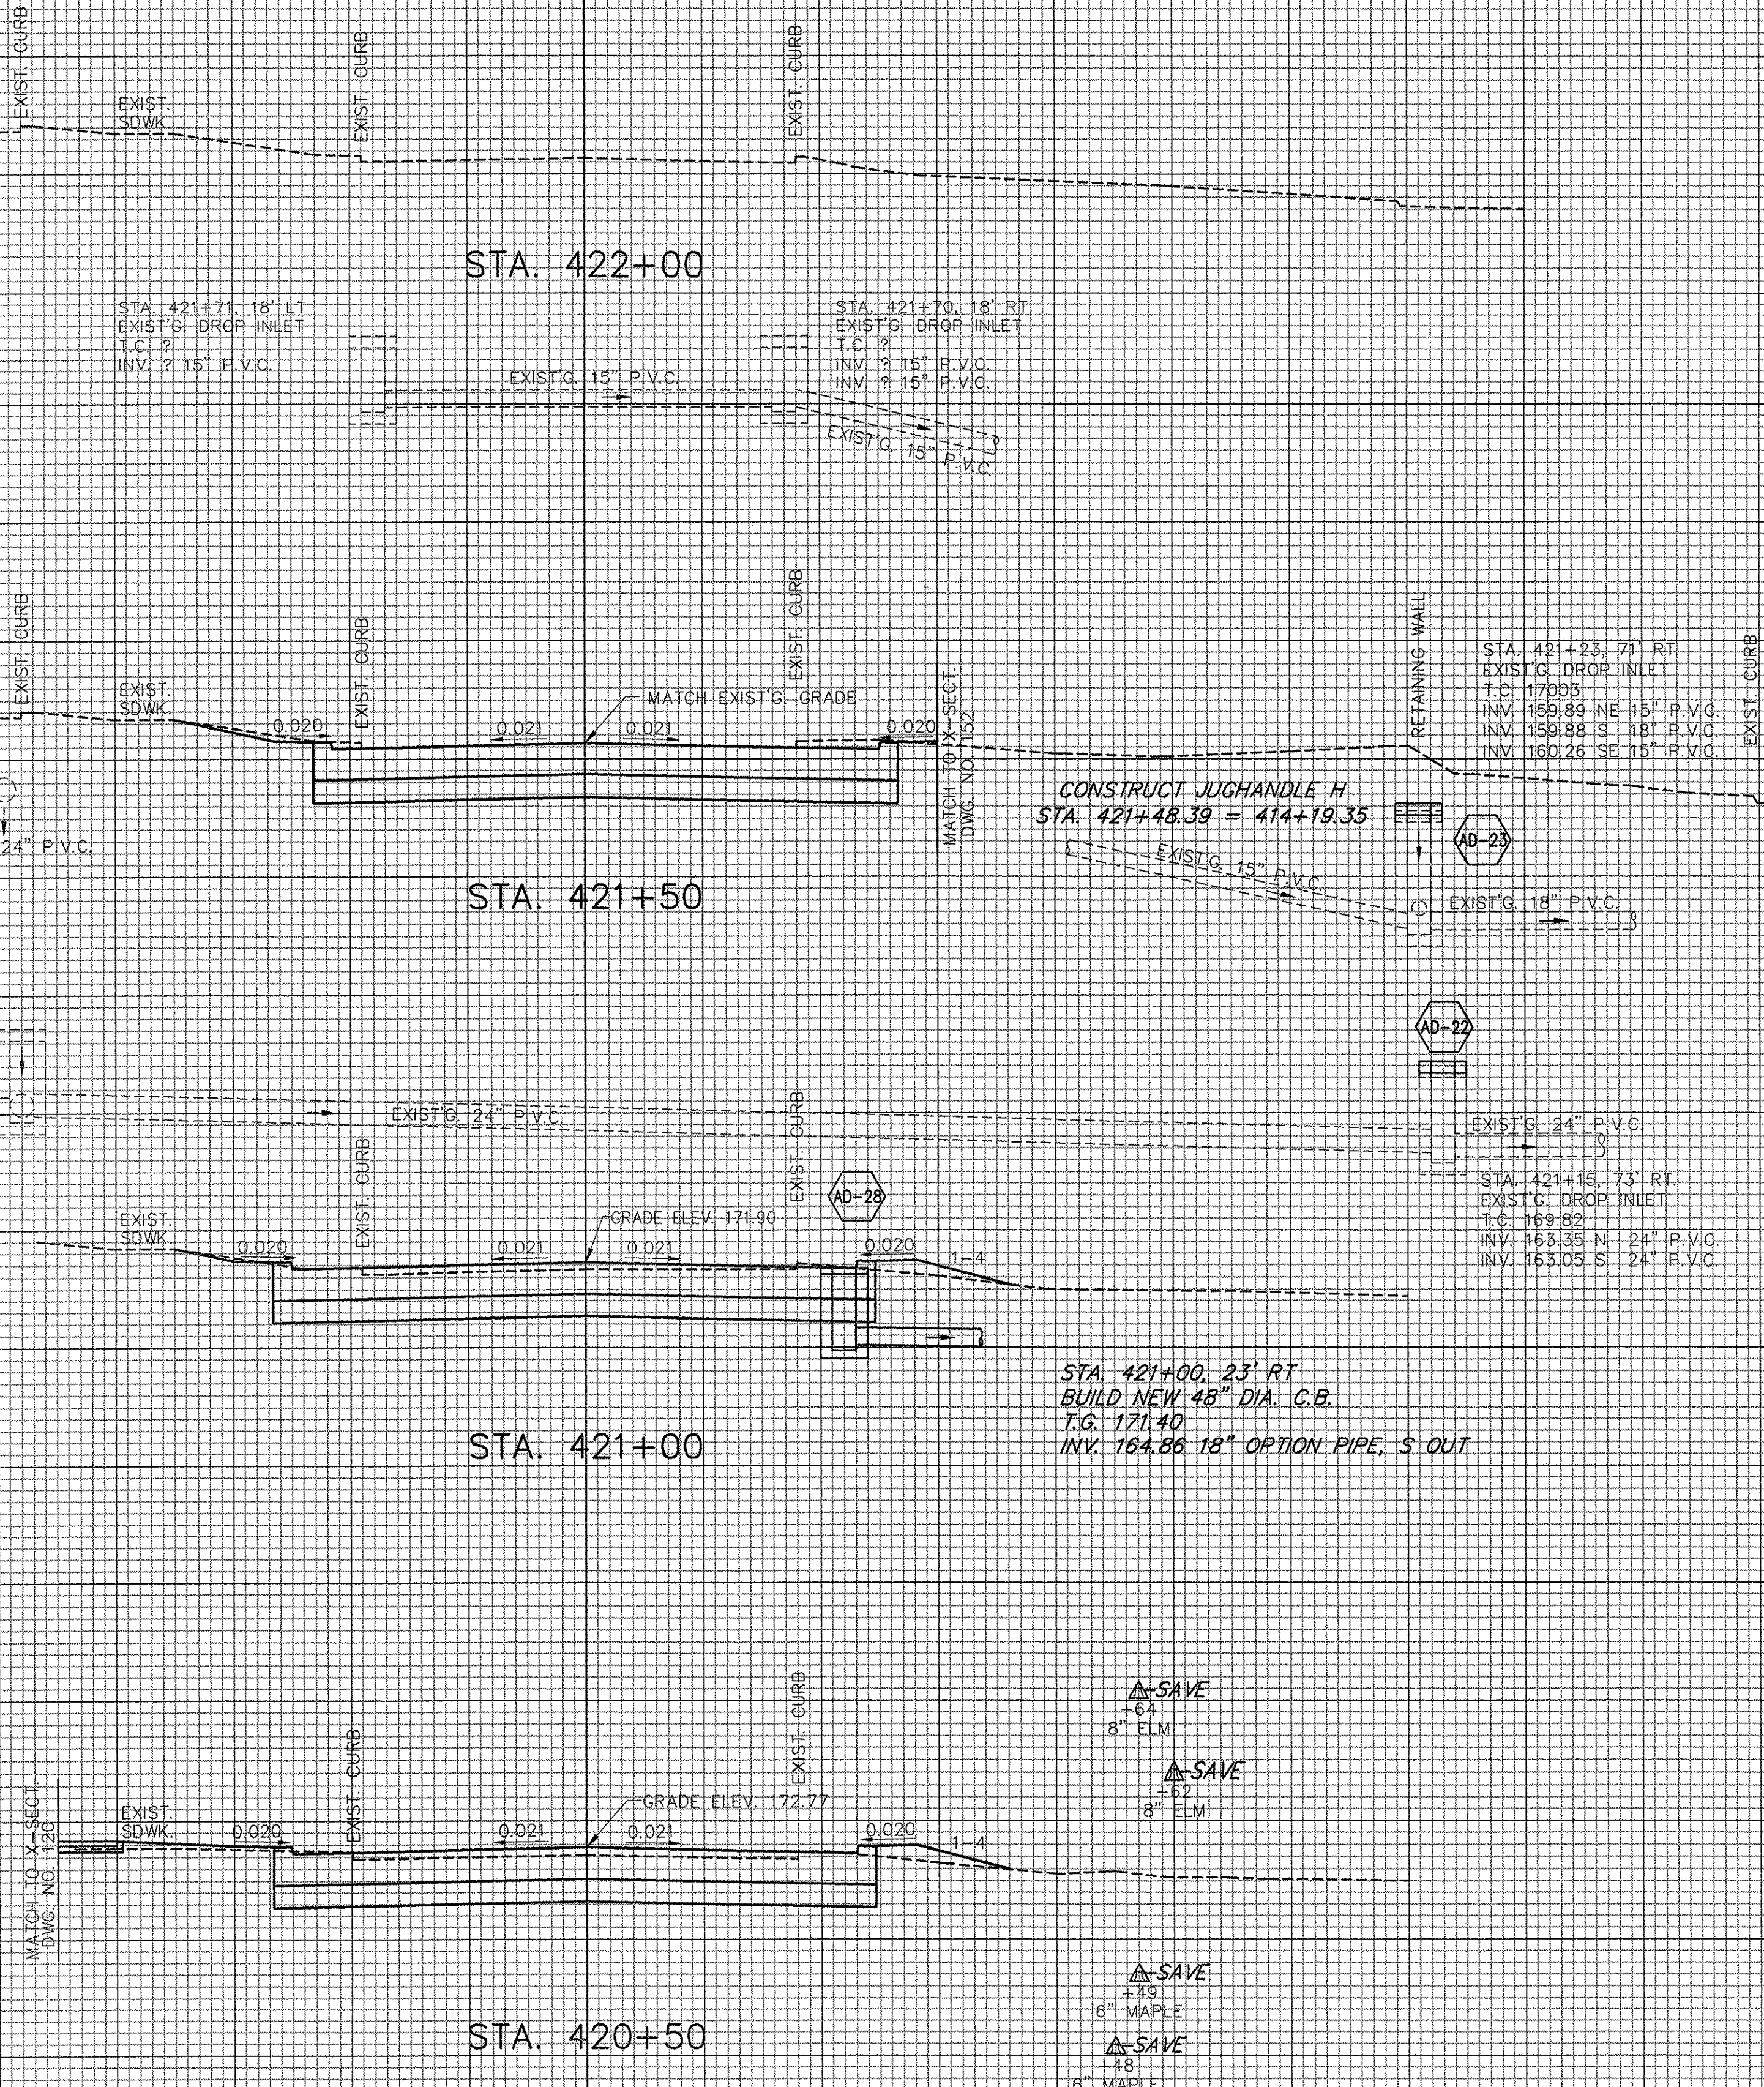

SEE MAINLINE SECTIONS
STA. 424+47.58

CONSTRUCT JUGHANDLE H
STA. 421+48.39 = 414+19.35


STA. 421+00, 23' RT
BUILD NEW 48" DIA. C.B.
T.G. 171.40
INV. 164.86 18" OPTION PIPE, S OUT

SAVE
+64
8" ELM

SAVE
+62
8" ELM

SAVE
+59
6" MAPLE

SAVE
+48
6" MAPLE

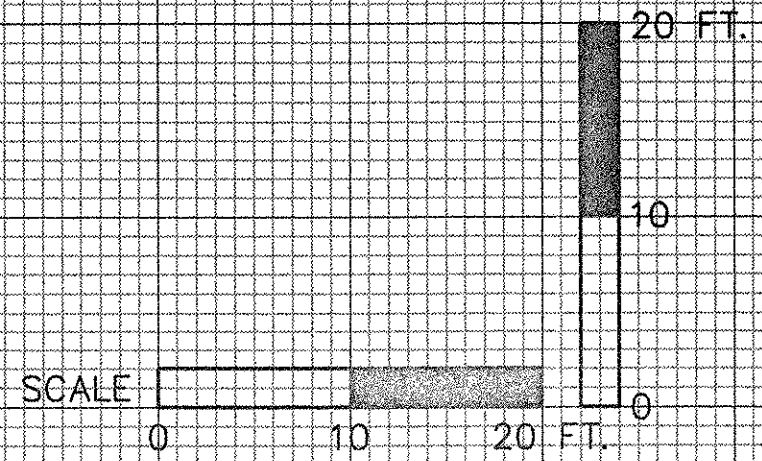

IDX DRIVE

SHELBURNE - SOUTH BURLINGTON

STA. 420+50 TO STA. 421+50

SURVEYED BY V.S.C. INC. DATE
DRAWN BY E.A.A. INC. DATE
TRACED BY E.A.A. INC. DATE

PROJECT NH-EGC-019-4(28)

CROSS-SECTION DWG. NO. 150

SHEET 222 OF 283