


DATUM ELEV = 160.00

DATUM ELEV = 160.00

DATUM ELEV = 160.00

DATUM ELEV = 160.00

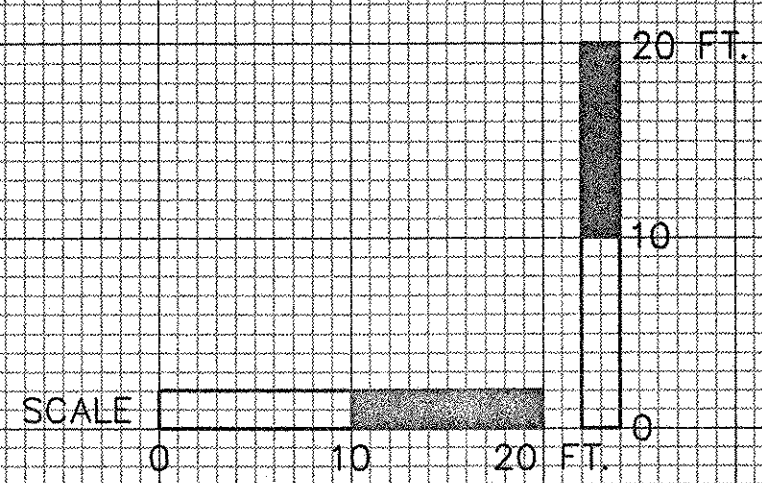

JUGHANDLE H

SHELburnE - SOUTH BURLINGTON
 STA. 412+00 TO STA. 413+50
 SURVEYED BY V.S.C. INC. DATE _____
 DRAWN BY E.A.A. INC. DATE _____
 TRACED BY E.A.A. INC. DATE _____
 PROJECT NH-EGC-019-4(28)
 CROSS-SECTION DWG. NO. 152
 SHEET 224 OF 283

ERDMAN ANTHONY
 CONSULTING ENGINEERS
 Rochester, New York Camp Hill, Pennsylvania
 Boston, Massachusetts

130 120 110 100 90 80 70 60 50 40 30 20 10 0 10 20 30 40 50 60 70 80 90 100 110 120

4/4/03