



U.S. ROUTE 7 SHELburne ROAD

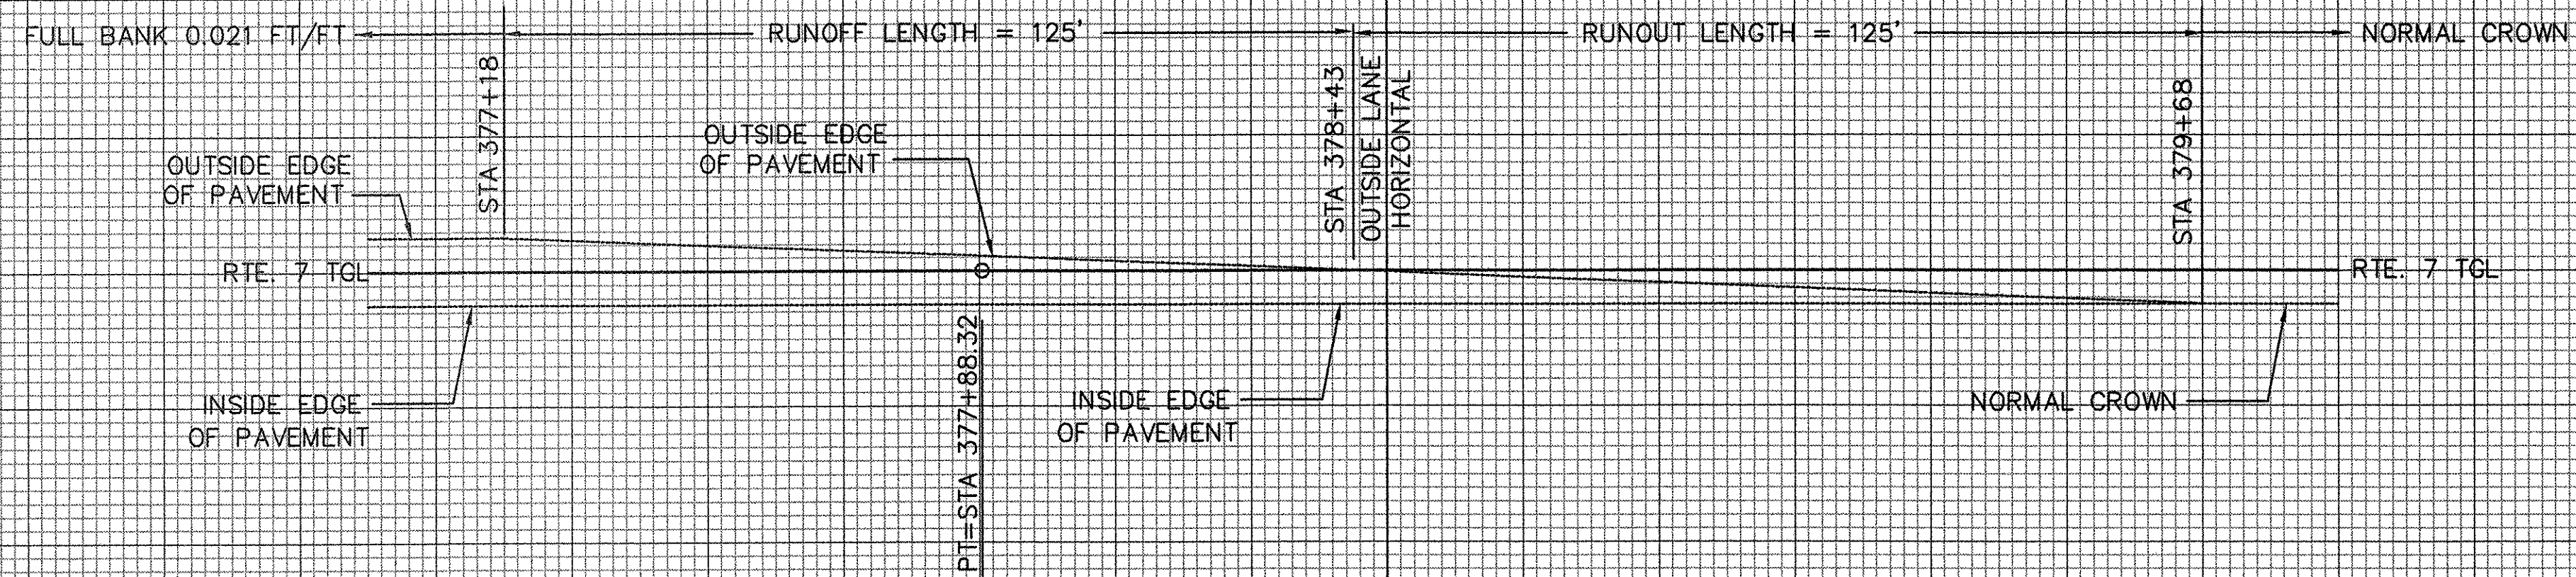

U.S. ROUTE 7 SHELburne ROAD

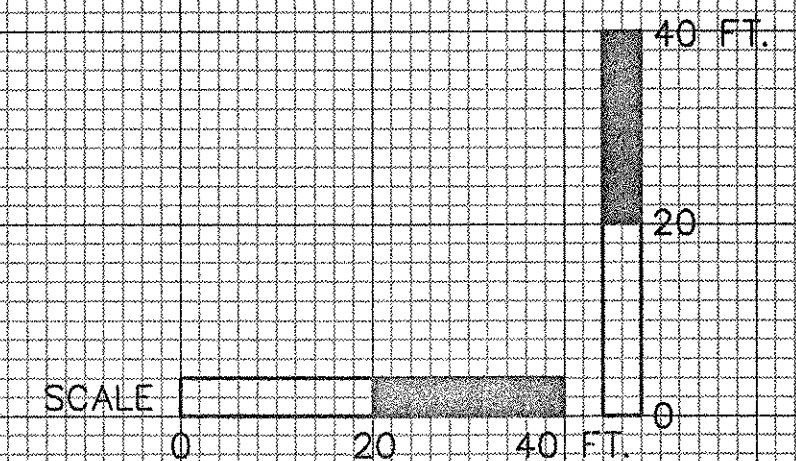

SHELburne - SOUTH BURLINGTON

STA. 370+17 TO STA. 379+68

SURVEYED BY V.S.C. INC. DATE
 DRAWN BY E.A.A. INC. DATE
 TRACED BY E.A.A. INC. DATE

PROJECT NH-EGC-019-4(28)

BANKING DWG. NO. 1

SHEET 233 OF 283