



Dedicated to Quality
 Water and Service

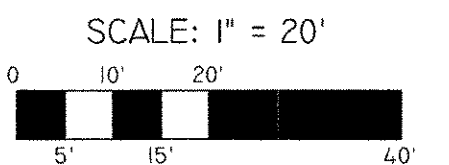


REVISIONS		
REV. #	DATE	BY

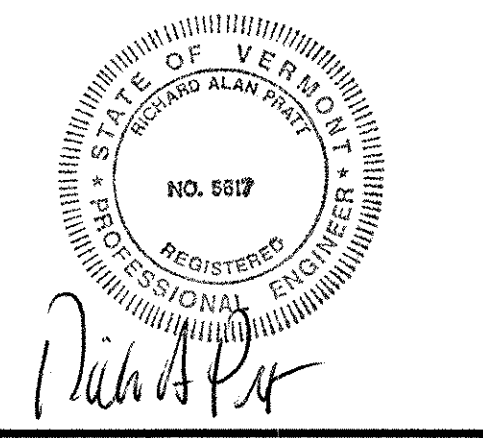

CONTRACT #63
 WATER MAIN RELOCATION
 U.S. ROUTE 7
 "SHELBURNE ROAD"
 SOUTH BURLINGTON,
 VERMONT
 PLAN VIEW
 STA. 387+00 TO 393+00

DATE: APRIL, 2002
 DESIGNED BY: RAP
 DRAWN BY: EJP
 CHECKED BY: RAP
 APPROVED BY: RAP
 FILE NAME: 2000_C63-PL2(26)
 SHEET 4 OF 18
 DRAWING No.

PL2
 245 OF 283

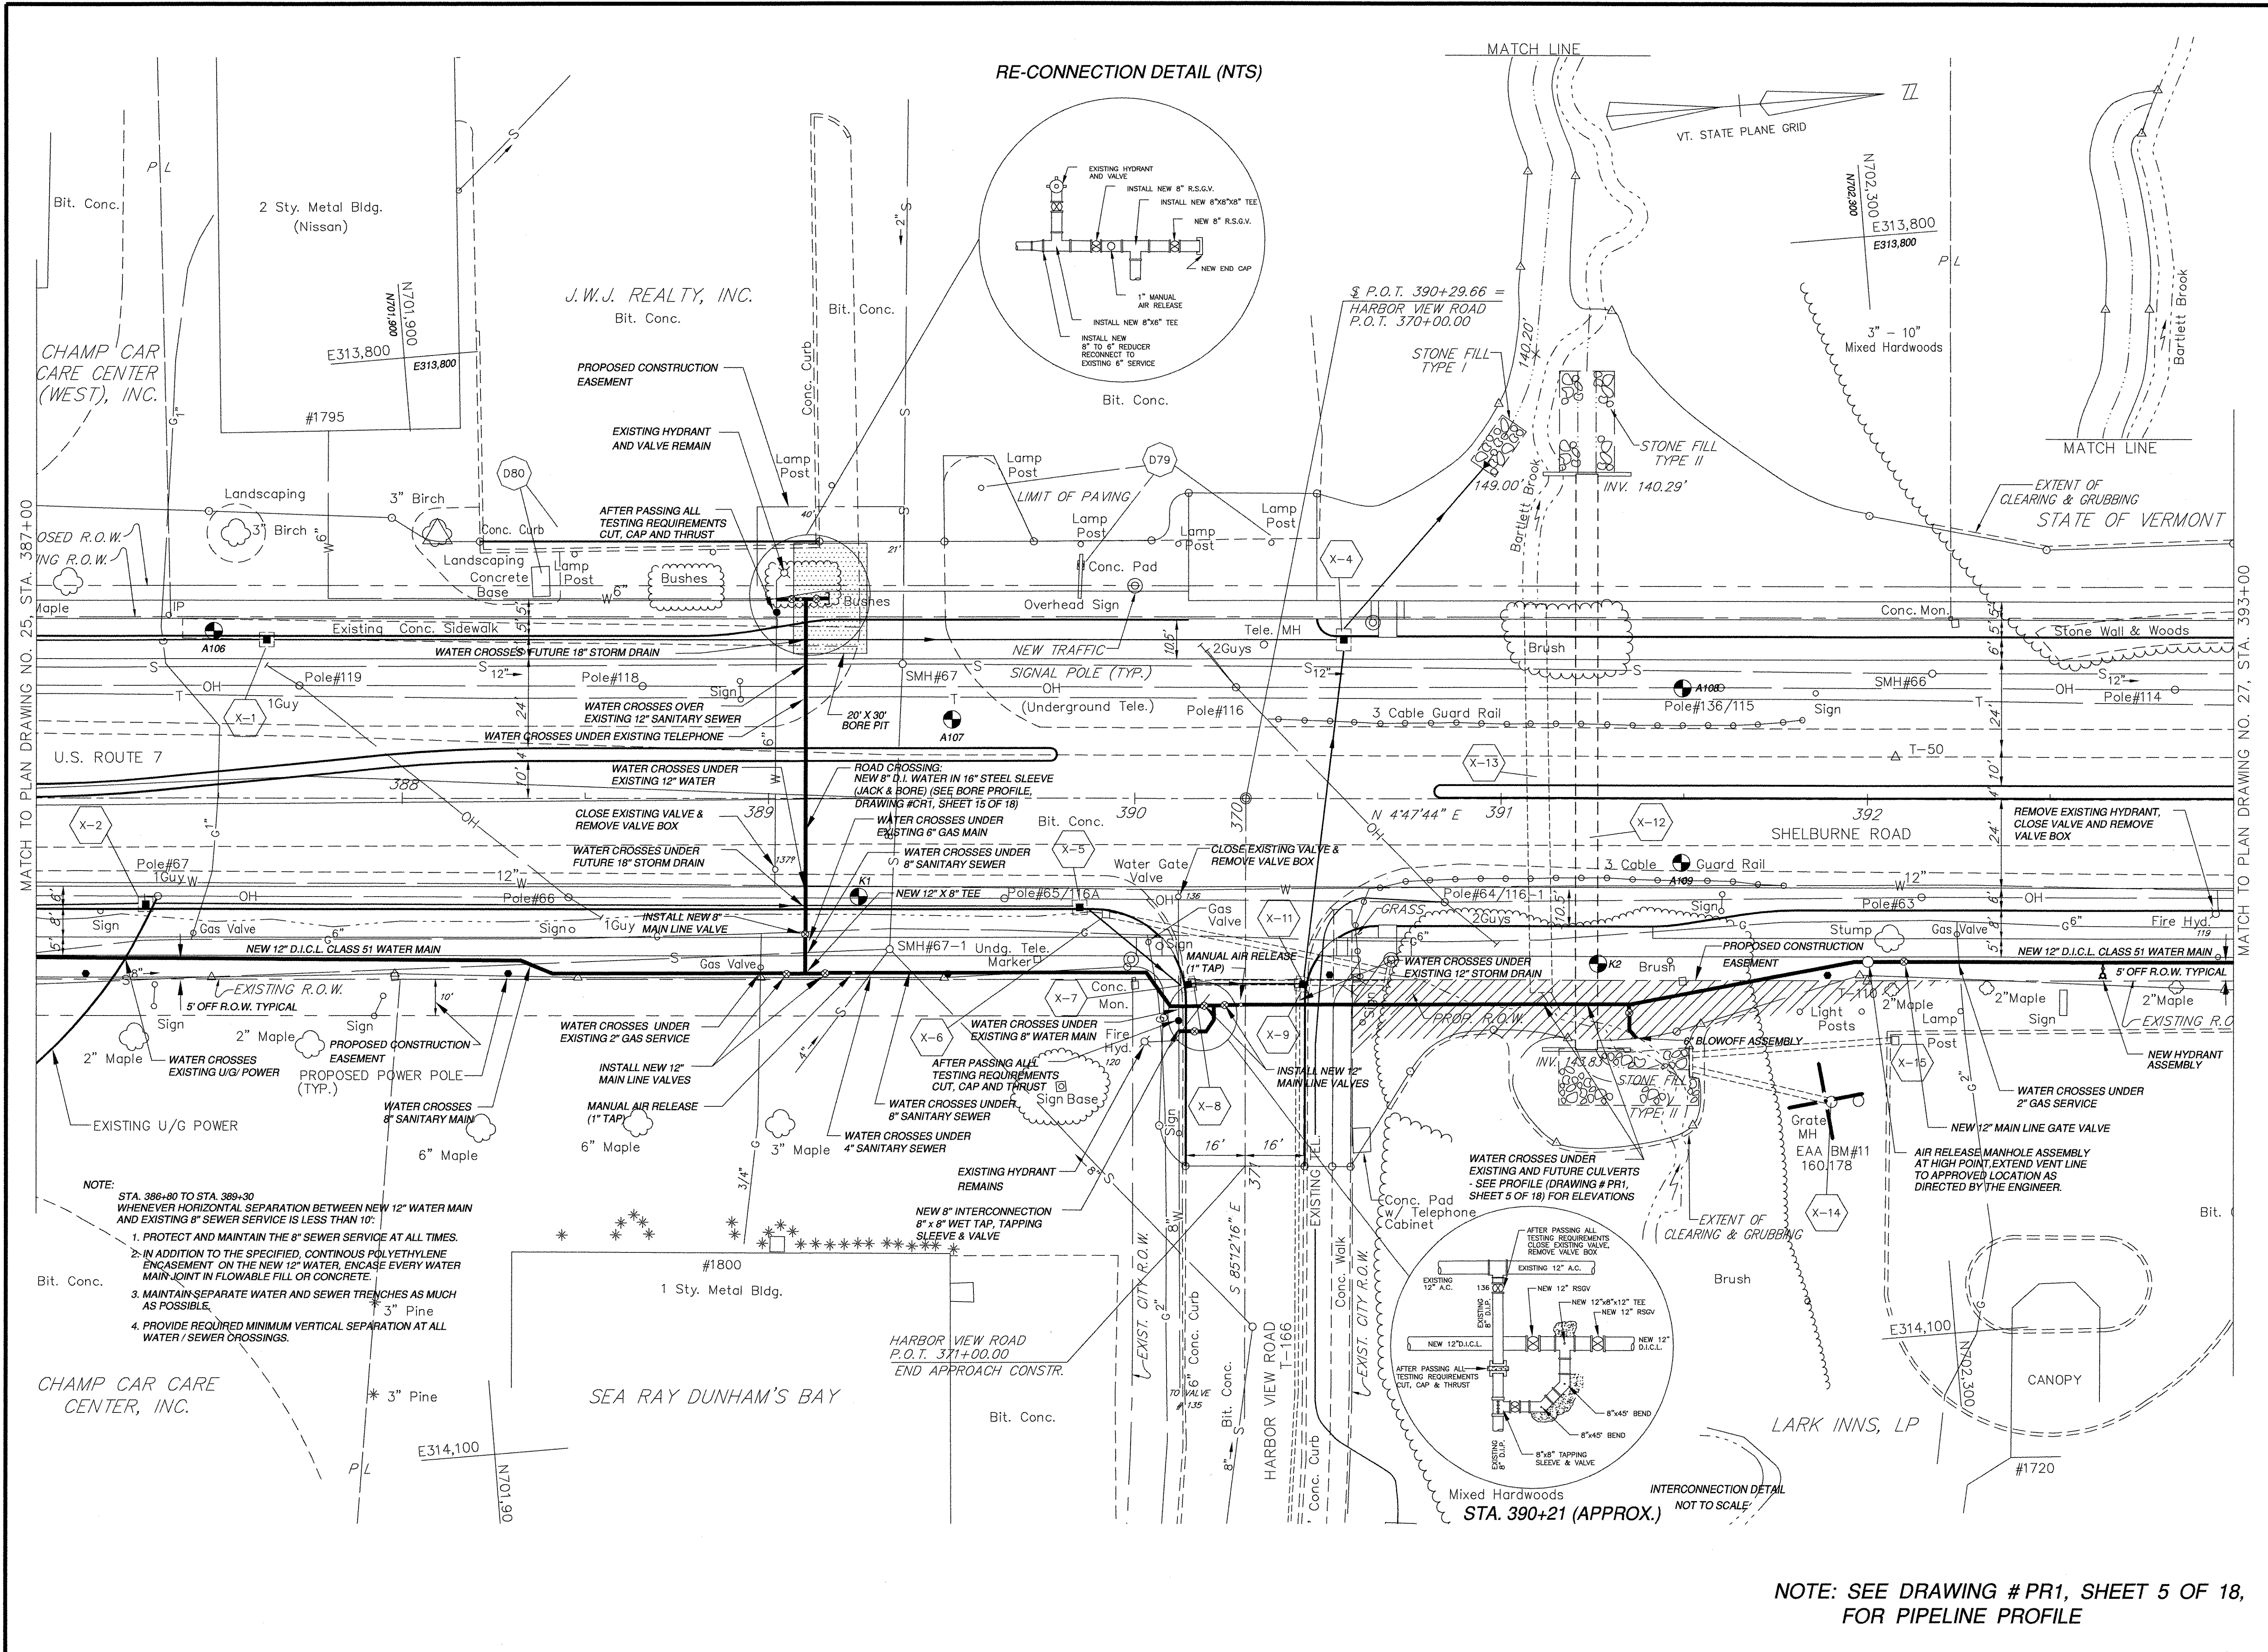

NOTE: SEE DRAWING # PR1, SHEET 5 OF 18,
 FOR PIPELINE PROFILE