


NOTE: STA. 386+80 TO STA. 389+30  
WHENEVER HORIZONTAL SEPARATION BETWEEN NEW 12" WATER MAIN AND EXISTING 8" SEWER SERVICE IS LESS THAN 10':

1. PROTECT AND MAINTAIN THE 8" SEWER SERVICE AT ALL TIMES.
2. IN ADDITION TO THE SPECIFIED, CONTINUOUS POLYETHYLENE ENCASEMENT ON THE NEW 12" WATER, ENCASE EVERY WATER MAIN JOINT IN FLOWABLE FILL OR CONCRETE.
3. MAINTAIN SEPARATE WATER AND SEWER TRENCHES AS MUCH AS POSSIBLE.
4. PROVIDE REQUIRED MINIMUM VERTICAL SEPARATION AT ALL WATER / SEWER CROSSINGS.

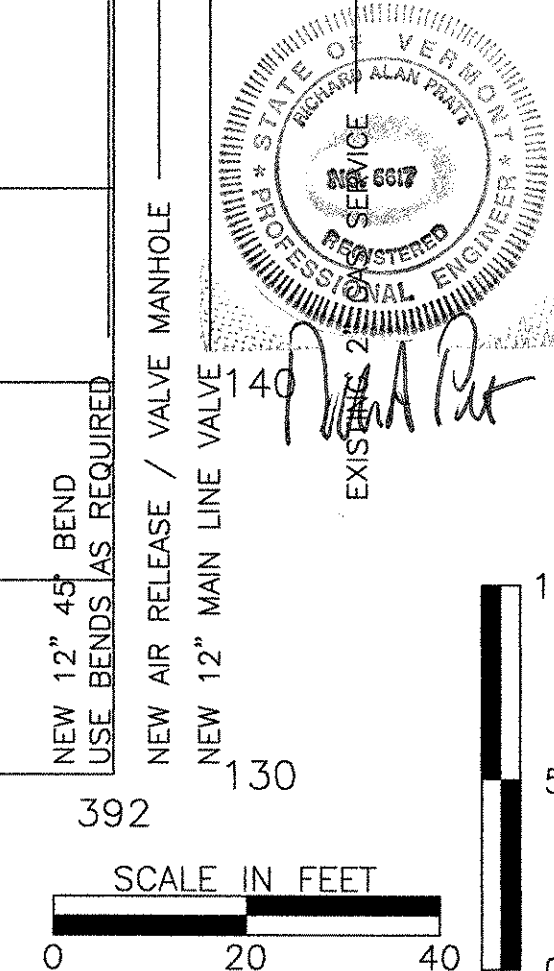

CONTRACT #63  
WATER MAIN RELOCATION  
U.S. ROUTE 7, "SHELBURNE RD"  
SOUTH BURLINGTON,  
VERMONT

PROFILE VIEW  
STA 381+00 TO 393+00

DESIGNED BY: RAP	DATE: APRIL, 2002
DRAWN BY: EJP	SCALE: AS SHOWN
CHECKED BY: RAP	DRAWING No.
APPROVED BY: RAP	PR1
FILE NAME: Pr1_2000	SHEET 5 OF 18