


John A. Poirer

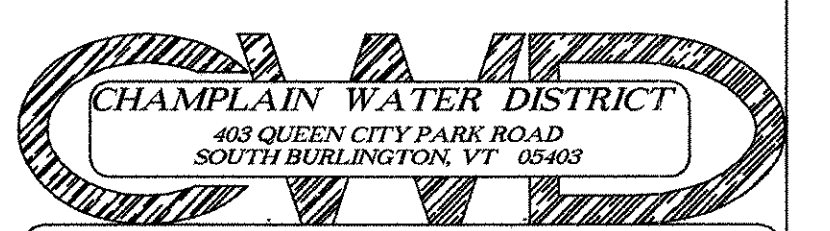

CONTRACT #63
WATER MAIN RELOCATION
 U.S. ROUTE 7, "SHELBURNE RD"
 SOUTH BURLINGTON,
 VERMONT

PROFILE VIEW
 STA 393+00 TO 405+00

DESIGNED BY: RAP	DATE: APRIL, 2002
DRAWN BY: EJP	SCALE: AS SHOWN
CHECKED BY: RAP	DRAWING No.
APPROVED BY: RAP	PR2
FILE NAME: Pr2_2000	SHEET 8 OF 18

