



405 +50 406 +50 407 +50 408 +50 409 +50 410 +50 411

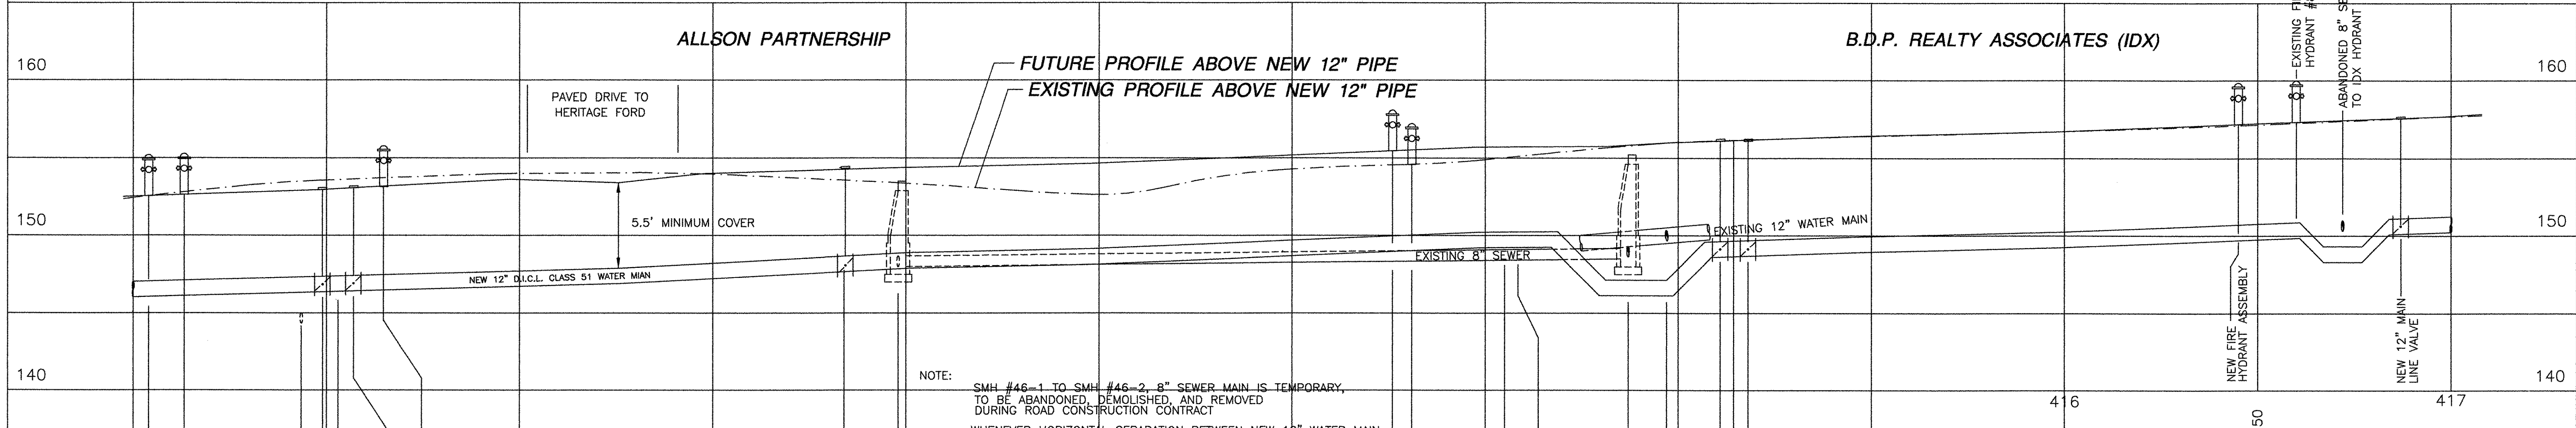

411 +50 412 +50 413 +50 414 +50 415 +50 416 +50 417

NOTE:
 SMH #46-1 TO SMH #46-2, 8" SEWER MAIN IS TEMPORARY, TO BE ABANDONED, DEMOLISHED, AND REMOVED DURING ROAD CONSTRUCTION CONTRACT.
 WHENEVER HORIZONTAL SEPARATION BETWEEN NEW 12" WATER MAIN AND EXISTING 8" SEWER SERVICE IS LESS THAN 10':
 1. PROTECT AND MAINTAIN THE 8" SEWER SERVICE AT ALL TIMES.
 2. IN ADDITION TO THE SPECIFIED, CONTINUOUS POLYETHYLENE ENCASUREMENT ON THE NEW 12" WATER, ENCASE EVERY WATER MAIN JOINT IN FLOWABLE FILL OR CONCRETE.
 3. MAINTAIN SEPARATE WATER AND SEWER TRENCHES AS MUCH AS POSSIBLE.
 4. PROVIDE REQUIRED MINIMUM VERTICAL SEPARATION AT ALL CROSSINGS.

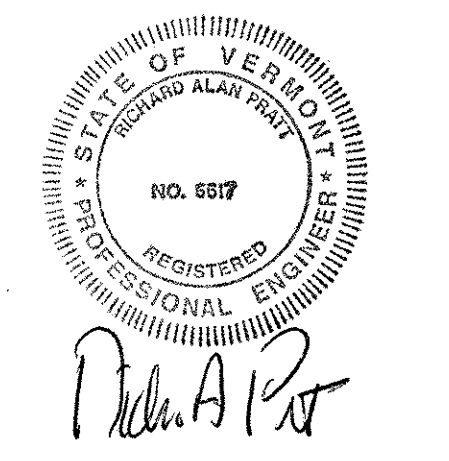

CONTRACT #63
WATER MAIN RELOCATION
 U.S. ROUTE 7, 'SHELBURNE RD'
 SOUTH BURLINGTON, VERMONT

PROFILE VIEW
 STA 405+00 TO 417+00

DESIGNED BY: RAP	DATE: APRIL, 2002
DRAWN BY: EJP	SCALE: AS SHOWN
CHECKED BY: RAP	DRAWING No. PR3
APPROVED BY: RAP	FILE NAME: PR3_east
	SHEET 11 OF 18

