


**CHAMPLAIN WATER DISTRICT**  
 403 Queen City Park Road  
 South Burlington, VT 05403  
 Phone: (802) 864-7454  
 Fax: (802) 864-0435

Dedicated to Quality Water and Service

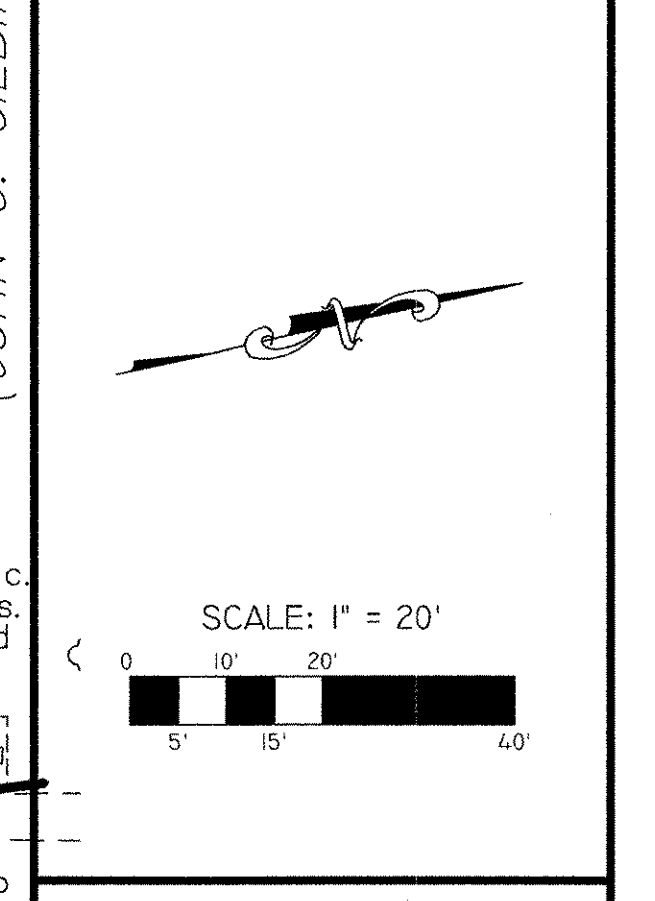

REVISIONS

| REV. # | DATE | BY |
|--------|------|----|
|        |      |    |
|        |      |    |
PAUL A. PER  
 REGISTERED PROFESSIONAL ENGINEER  
 NO. 6617

**CONTRACT #63**

WATER MAIN RELOCATION  
 U.S. ROUTE 7  
 "SHELburne ROAD"

SOUTH BURLINGTON,  
 VERMONT

PLAN VIEW  
 STA. 423+00 TO 429+00

DATE: APRIL, 2002  
 DESIGNED BY: SGW  
 DRAWN BY: EJP  
 CHECKED BY: RAP  
 APPROVED BY: RAP  
 FILE NAME: 2000C63-p18(32)  
 SHEET 13 OF 18  
 DRAWING No.

PL8  
 254 OF 283

NOTE: SEE DRAWING PR4, SHEET 14 OF 18, FOR PIPELINE PROFILE