


NOTE:  
 USE SERVICE TAP AS TEMPORARY  
 MANUAL AIR RELEASE UNTIL COMPLETION OF  
 PIPE TESTING, AND PRIOR TO SERVICE  
 RECONNECTION (#1525 JIFFY LUBE)

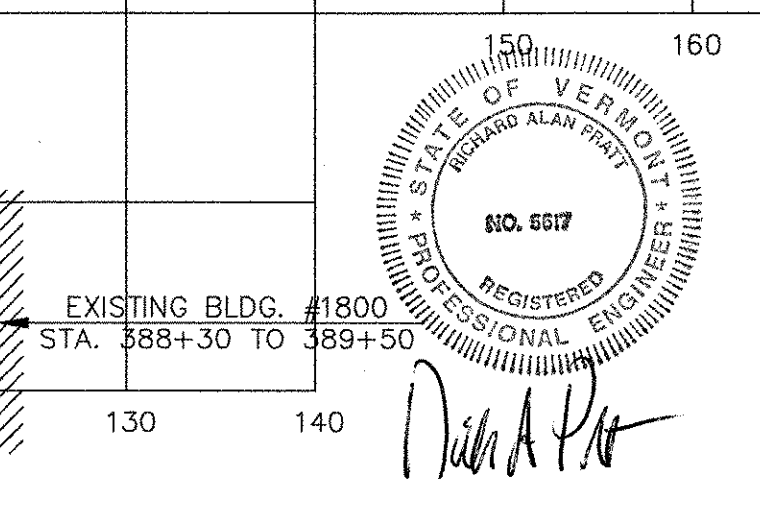

**CONTRACT #63**  
 WATER MAIN RELOCATION  
 U.S. ROUTE 7, "SHELburne RD"  
 SOUTH BURLINGTON,  
 VERMONT  
 ROAD CROSSINGS  
 1, 2 & 3 OF 8

DESIGNED BY: RAP	DATE: APRIL, 2002
DRAWN BY: EJP	SCALE: AS SHOWN
CHECKED BY: RAP	DRAWING No.
APPROVED BY: RAP	<b>CRI</b>
FILE NAME: 2000_CROSS1	SHEET 15 OF 18