


⑦ STA. 418+42.5 LT : END OF 2" DRISCO 8000 PE GAS w/2" PURGE PT. CAP ON 11/87. LOCATOR BOX w/WIRE OVER END.

TO #1459 REAR

CRANE, EDWARD B., Trustee,
EDWARD B. CRANE LIVING TRUST

TWO O'BRIENS PROPERTIES, LLC

SOCINSKI, ANTHONY A.

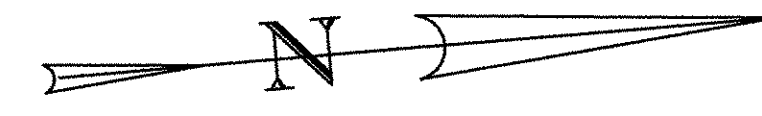

⑧ STA. 422+43.1 LT : END OF 2" DRISCO 8000 PE GAS w/2" PURGE PT. CAP ON 5/27/94. LOCATOR BOX w/WIRE OVER END.

MATCH TO PLAN DRAWING NO. 30 STA. 417+00

MATCH TO PLAN DRAWING NO. 32 STA. 423+00

U.S. ROUTE 7

SHELBURNE ROAD

IDX SYSTEMS CORP.

VERMONT GAS SYSTEMS, INC.
NATURAL GAS PIPELINE
PRESSURE: MEDIUM
SHELBURNE RD. ROUTE 7
SO. BURLINGTON
 DWN. BY: ERDMAN ANTHONY
DATE: FEBRUARY, 1996
SCALE: 1"=20' **SHEET: 31**

- STA. 417+00—423+00 55' LT RTE. 7 : PROPOSED NEW 6" X TRU STEEL .188 W.T. GAS w/WELD JOINTS.
- STA. 417+00—420+48.6 RT RTE. 7 : EXIST. 6" X TRU STEEL .188 W.T. GAS TO BE RETIRED IN PLACE. INST. OCTOBER OF 1969 w/WELD JOINTS UNLESS OTHERWISE STATED.
- STA. 420+48.6—423+00 RT RTE. 7 : EXIST. 6" X TRU STEEL .188 W.T. GAS TO BE RETIRED IN PLACE. INST. NOVEMBER OF 1968 w/WELD JOINTS UNLESS OTHERWISE STATED.
- STA. 420+73.8 RT—LT ASKEW RTE. 7 : EXIST. 2" X TRU STEEL SCH. 40 GAS TO BE RETIRED IN PLACE. INST. 11/23/68 w/WELD JOINTS.
- STA. 418+42.5—419+53.1 LT RTE. 7 : EXIST. 2" DRISCO 8000 PE GAS TO BE RETIRED IN PLACE. INST. 11/87 w/BUTT FUSION JOINTS UNLESS OTHERWISE STATED.
- STA. 419+53.1—420+79.2 LT RTE. 7 : EXIST. 1-1/4" X TRU STEEL SCH. 40 GAS TO BE RETIRED IN PLACE. INST. 11/6/69 w/WELD JOINTS UNLESS OTHERWISE STATED.
- STA. 420+79.4—422+43.1 LT RTE. 7 : EXIST. 2" DRISCO PE 8000 GAS TO BE RETIRED IN PLACE. INST. 5/27/94 w/BUTT FUSION JOINTS UNLESS OTHERWISE STATED.

① STA. 417+35 RT RTE. 7 = 0+13.4—0+16 RT IDX
 TAPPED EXIST. 6" X TRU STEEL INST. OCTOBER OF 1969 w/1-1/4" NOBLOW CURB VALVE TEE w/1 STEEL-PE TRANS. FIT. HEADED EAST ON 11/21/85. 3' EAST OF TEE—CAPPED EXIST. 1" DRISCO 8000 PE GAS INST. 11/21/85 ON 10/27/99 STUBBING MAIN. LOCATOR BOX w/WIRE OVER CAP. WELD/BUTT FUSIONS. TO BE RETIRED w/6" X TRU MAIN.

② STA. 420+48.6 RT ROUTE 7
 APPRX. TIE-IN & EXT. SOUTH OCTOBER 1969. NORTH OF HERE INSTALLED NOVEMBER OF 1968. TIED-IN w/6" DRESSER COUP. OCTOBER OF 1969.

③ STA. 420+67.4 32' RT : TAPPED EXIST. 6" X TRU STEEL INST. NOVEMBER OF 1968 w/2" NOBLOW TEE. 1'1" WEST OF TEE—2" LUB. PLUG VALVE. COMPLETED 11/23/68.

④ STA. 420+79.2 28.5' LT : TAPPED EXIST. 2" X TRU STEEL INST. 11/23/68 w/1-1/4" NOBLOW CURB VALVE TEE ON 11/6/69.

⑤ STA. 420+79.4 38.3' LT : TAPPED EXIST. 2" X TRU STEEL INST. 11/23/68 w/2" BOTTOM OUT STOP. FIT. w/2"x90" WELD STEEL ELL & 2" STEEL-PE TRANS. FIT. HEADED NORTH. 2'9" NORTH OF TEE—TWO 2"x90" PE ELLS—1'4" HORIZ. OFFSET—EAST. 9" NORTH OF EAST ELL—2" PE BALL VALVE. LOCATOR BOX w/WIRE OVER TEE. COMPLETED 5/27/94.

⑥ STA. 419+53.1 LT : TIED-IN TO EXIST. 1-1/4" X TRU STEEL GAS (INST. 11/6/69) w/1-1/4" POSI—1/4" STEEL-PE TRANS. FIT. & 1-1/4"x2" PE EXPANDER HEADED SOUTH ON 11/87. LOCATOR BOX w/WIRE NEAR TIE-IN.

VAOT PROJ. # NH-EGC-019-(428)
 GAS DESIGN & ASBUILT BY M.A. OF VGS.

SEE IDX SHEET 4

STA. 2+41.6 IDX