


HANDY, PAUL L. & CATHERINE M.

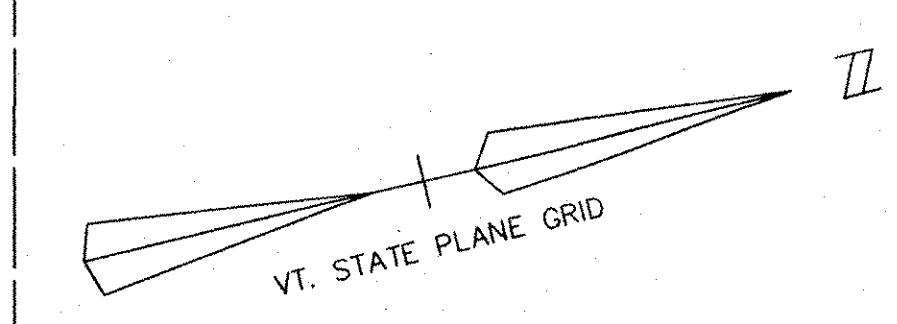


PINE HAVEN SHORES ROAD

Install	Remove	Transfer
	2-3" PRI UNG RISERS + 2-C/O & ARR	SWING UNG SEC FOR LIGHTS INTO (N)PAD -50
	1-1/2" SEC RISER	

CLIMB HIGH, INC.

Install	Remove	Transfer
	162' OF #4 TRI SEC	SWING OH PRI AND NEUT OF (R)P1/4 TO (N)P3-11
	1-15KVA XFMR + C/O	1-FLOOD LIGHT TO (N)P3-21

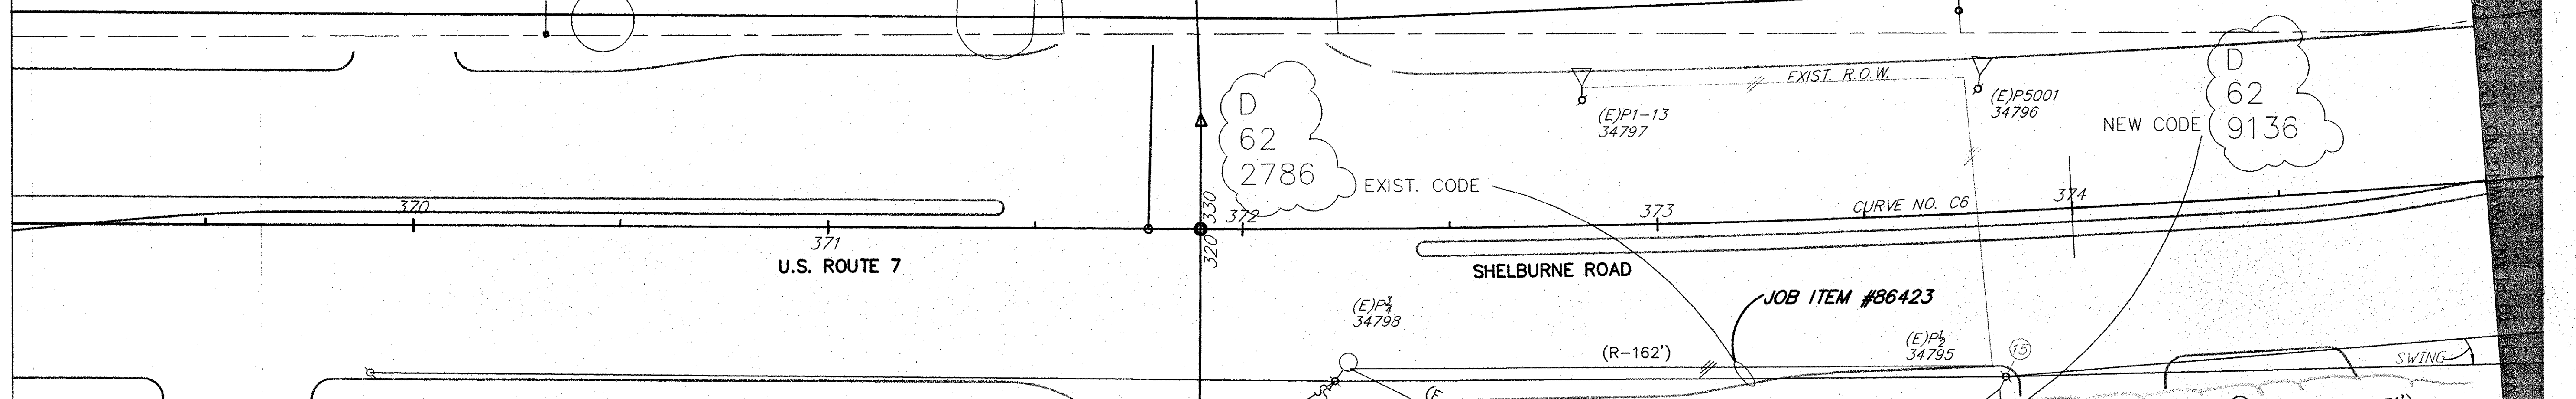

LOCUST HILL DRIVE

KIM E. LASH, REVOCABLE TRUST
LASH, KIM E., TRUSTEE

ROBERTS, LAWRENCE R. & ROBERTS, SHIRLEY T.

QUAISE REALTY, LLC

SIRLOW SALOON OF SHELBURNE, INC.

NOTE: INSTALL 2-3" 1# UNG PRI DUCT OUT OF MTC & 1-3" SEC DUCT OUT OF P/M XFMR FOR FUTURE SEC/SERV

Install	Remove	Transfer
	2-55' RUNS OF 1# PRI UNG	EXPOSE/CUT/SWING 2-EXIST 1# UNG PRI INTO NEW UNITS

LOCUST HILL DEVELOPMENT, INC.

Install	Remove	Transfer
	1-RUN OF 1# UNG PRI & NEUT	EXPOSE/CUT/SWING 1# UNG PRI
	1-1# MTC UNIT + 2-LB ELBOWS	

NOTE: GMP TO TRENCH/DUCT/BACKFILL AS REQ'D

Install	Remove	Transfer
	1-1# OH PRI D.E.	TAP EXIST OH SERV TO NEW SEC
	173' OF OH 1#	UNG SERV INTO (N)PAD -50
	1/0 PRI & NEUT	
	173' OF 1/0 TRI OH SEC	
	2-3" 1# UNG PRI RISERS + 2-C/O & ARR & FUSE AT 65K	
	1-(JO) ANCH & GUY	
	1-NEUT D.E.	

Install	Remove	Transfer
	1-RUNS OF 1# UNG PRI & NEUT	EXPOSE/CUT/SWING 1# UNG PRI
	1-25KVA 1# PAD XFMR + 2-LB ELBOWS	VERIZON UNG SERV & DUCT OFF P3-22 UNG SEC TO LIGHTS OFF P3

Install	Remove	Transfer
	45' #3 POLE	1-FLOOD LIGHT FROM (E)P3
	1-PIN TOP	
	171' OF 1# 1/0 OH PRI & NEUT	
	1-25KVA OH XFMR + C/O	
	1-(JO) ANCH & GUY	
	1-NEUT BKT	

(E)P3-01 to P3-22/VZ1
102060
372+63 @ 54' RT

(N)PAD 10
102062
320+90 @ 25' LT

(N)PAD -50
102061
320+80 @ 25' LT

(N)P3-21/VZ2
102059
374+38 @ 57' RT

49.03 mm

HAS YET TO BE FINISHED - POLES/ANCHORS IN

MATCH TO PLAN DRAWING NO. 11, STA. 369+00

SHEET 272 OF 283

<p>GREEN MOUNTAIN POWER CORPORATION SOUTH BURLINGTON, VERMONT</p>			
12470Y 4W 3PH FEEDER			
<h2>32G4 OVERHEAD</h2>			
SHELBURNE ROAD RECONSTRUCTION			
DRAWN: LAW	CHECKED: MM	APPROVED: WH	SCALE: 1"=20'
DATE: 9-17-02	DRAWING NO. PL-23_4_12		SHEET: 12

ROUTE 7 "PHASE-1" JOB ITEM # ARE-00712-86423 & 86422
DRAWINGS/DISTRB/ROUTE7/REVISED 3-4-02/A0054591101