


STATE OF VERMONT

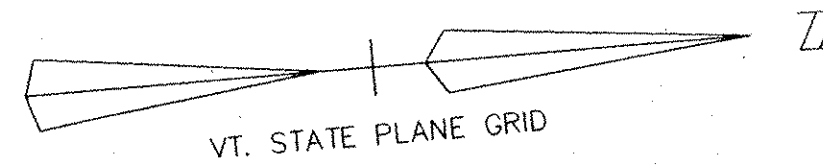

NOTE: P51 WILL HAVE 6' OF FILL AND SO-VZ ANCHOR WILL HAVE 3' OF FILL ADD ROD EXTENTION LEAVING 3' + OUT OF GROUND

SHEARER, JOHN F.

REYES, ALBERT J. & RITA J.

(N)P51/VZ108

Install	Remove	Transfer
55' #1 POLE 1-SGL X-ARM 130' OF 3# 477 PRI & 4/0 NEUT 1-25KVA XFMR + CO 1-NEUT BKT	40' POLE 1-SGL X-ARM 154' OF 3# 336 PRI & 4/0 NEUT 1-NEUT BKT	

NOTE: SEE SHEET 14 FOR INSTALL (N)P62

Install	Remove	Transfer
50' #2 POLE 1-SGL X-ARM 117' OF 3# 477 PRI & 4/0 NEUT 1-3# XFMR BANK W/3-SUB + 3-CO @ 120/208 1-NEUT BKT	40' POLE 1-SGL X-ARM 152' OF 3# 336 PRI & 4/0 NEUT 152' OF #6 TRI SEC 1-5" PRI RISER & 3-CO/ARR 1-NEUT BKT	

NOTE: SEE SHEET 15 FOR INSTALL (N)P60

(E)P59-02 to 52-02
/VZ100A to 109A2
34688

(E)P52-01/VZ019A1

Install	Remove
151' OF 3# 1/0 OH PRI & NEUT 151' OF 1/0 TRI SEC 1-(JO) ANCH & GUY	126' OF 3# 1/0 OH PRI & NEUT 126' OF 1/0 TRI SEC 1-(JO) ANCH & GUY

Install	Remove
55' #1 POLE 1-ANGLE DBL X-AMRS 175' OF 3# 477 OH PRI & 4/0 NEUT 1-(SO-GMP) ANCH & 3-GUY 2-(SO-VZ) ANCH 2-NEUT D.E.	

(E)P59-01 to
52-01/VZ100 to 109A1
34688

147.50' 147.25' 147.00'

(N)15' L. ANC.
FOR VERIZON ONLY

(N)15' L. ANC.
FOR VERIZON ONLY

(N)P51/VZ108
102033
397+90 @ 56 1/2 LT

U.S. ROUTE 7

SHELburnE ROAD

D 45
4426

MATCH TO PLAN DRAWING NO. 15, STA. 393+00

MATCH TO PLAN DRAWING NO. 17, STA. 399+00

(R)P62/VZ116-3
34750

(R-154')

(R)P60/VZ116-4
34749

(R-152')

(R)P59/VZ115
34745

(R-126')

(R)P58
34744

(R-158')

(N)P55/VZ112
102037
393+32 @ 48 1/2 RT

(N-130')

(N)P54/VZ111
102036
394+62 @ 48 1/2 RT

(N-110')

(N)P53/VZ110
102035
395+72 @ 48 1/2 RT

(N-110')

(E)P53 to P52/VZ104A
to 109
34745

396+82 @ 48 1/2 RT

147.20'

146.25'

145.00'

(N)P55/VZ112

Install	Remove	Transfer
50' #2 POLE 1-SGL X-ARM 130' OF 3# 477 PRI & 4/0 NEUT 1-NEUT BKT	35' POLE 1-SGL X-ARM 135' OF 3# 336 PRI & 4/0 NEUT 1-NEUT BKT	

NOTE: SET POLE AT 8' DEPTH FOR 1' FUTURE CUT

(N)P55/VZ112

DISCONNECT & PULL BACK UNG PRI, EXPOSE/EXTEND EXIST. 5" PRI DUCT, PULL BACK IN & RETERMINATE AS REQ'D.

(N)P53/VZ110

Install	Remove
50' #2 POLE 1-SGL X-ARM 110' OF 3# 477 PRI & 4/0 NEUT 1-NEUT BKT	35' POLE 1-SGL X-ARM 158' OF 3# 336 PRI & 4/0 NEUT 1-5" PRI RISER 3-CO & ARR 1-NEUT BKT 1-GMP ANCH & GUY

NOTE: SEE SHEET 18A FOR REMOVAL (R)P53

(E)P53 to P52/VZ109

Install	Remove	Transfer
1-ANGLE DBL X-ARMS 1-DBL X-ARMS D.E. 3-C/O @ 12K FUSES 151' OF 3# 477 PRI & 4/0 NEUT 1-25 KVA XFMR + CO 1-NEUT BKT 1-NEUT D.E. 2-SPAN GUYS	52' OF 1/0 TRI SEC TAPE EXIST UNG SERV	

SMART SUITES, LLC

KURT V. REICHEL & LAURA M. REICHEL, Trustees of the KURT V. REICHEL REVOCABLE TRUST

(N)P52-30/VZ109A
102034

(N)25' (VZ) & 28' (GMP) L. ANC.

(R)P58/VZ???

Install	Remove	Transfer
50' #2 POLE 1-SGL X-ARMS 130' OF 3# 477 PRI & 4/0 NEUT 1-3# XFMR BANK W/3-15s + 3-CO @ 120/208 1-NEUT BKT	40' POLE 1-SGL X-ARMS 158' OF 3# 336 PRI & 4/0 NEUT 1-NEUT BKT	

NOTE: SEE SHEET 15 FOR INSTALL (N)P58

LARK INNS, LP

D 45
4288

(E)PAD1

Install	Remove
20' OF 5" PRI UNG DUCT	15' OF 3# 1/0 PRI UNG & NEUT

(E)PAD1
92582

(N)P54/VZ111

Install	Remove	Transfer
50' #2 POLE 1-SGL X-ARM 110' OF 3# 477 PRI & 4/0 NEUT 1-5" PRI RISER & 3-CO @ 100K FUSES & ARR 1-NEUT BKT	35' POLE 1-SGL X-ARM DBL D.E. W/ARR 136' OF 3# 336 PRI & 4/0 NEUT 1-10 KVA XFMR + CO 1-NEUT BKT 1-1/2" SEC RISER	3# 1/0 UNG PRI & NEUT FROM (R)P60

NOTE: SEE SHEET 17 FOR REMOVAL (N)P54

(R)P59/VZ???

Install	Remove	Transfer
50' #2 POLE 1-SGL X-ARMS 1-SGL X-ARM D.E. 1-3# 477 & 1/0 FUSES 117' OF 3# 477 PRI & 4/0 NEUT 1-NEUT D.E. 1-NEUT BKT	45' POLE 1-SGL X-ARM 1-DBL X-ARM D.E. 126' OF 3# 336 PRI & 4/0 NEUT 1-25 KVA XFMR + CO 1-(JO) ANCH & GUY 1-STREET LIGHT 1-NEUT D.E. 1-NEUT BKT	

NOTE: SEE SHEET 15 FOR INSTALL (N)P59

(N)P52-30/VZ109A

Install	Remove
45' #3 POLE 1-(SO-GMP) ANCH & 2-GUYS 1-(SO-VZ) ANCH	

NOTE: FRONT ANCH FOR VERIZON ONLY

2-ADDITIONAL ANCHORS WERE ADDED 4-9-09 mm

KURT V. REICHEL & LAURA M. REICHEL, Trustees of the KURT V. REICHEL REVOCABLE TRUST

GREEN MOUNTAIN POWER CORPORATION
SOUTH BURLINGTON, VERMONT
12470Y 4W 3PH FEEDER
32G4 OVERHEAD
SHELburnE ROAD RECONSTRUCTION

DRAWN: LAW	CHECKED: MM	APPROVED: WH	SCALE: 1"=20'
DATE: 8-9-02	DRAWING NO: PL-27-4_16	SHEET: 16	