


SHEARER, JOHN F.

BARTLETT BAY ROAD

POMERLEAU, ANTONIO
#1525

LASH, MILLICENT C.
#1515

#1519 - 1517

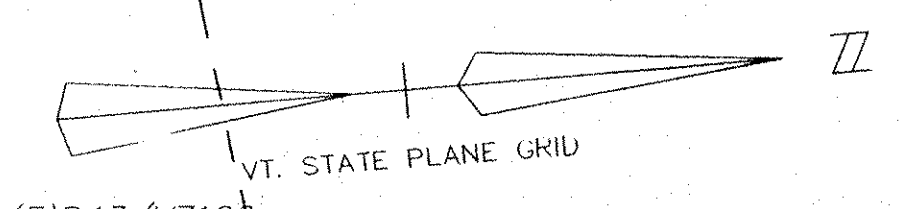

(E)P46/VZ103
102027

(E)P-50/VZ $\frac{1}{2}$
102024

(E)P45/VZ102
102023

(E)P44/VZ101
102022

(E)P43/VZ100
102021

(E-186')

(E-118')

(E-76')

(E-143')

(E-171')

D
45
4426

(E)P47E/VZ103E
34691

(R)P46E/VZ102E
34690

(TOPPED)P45/VZ101
34689

(R-158')

(R-137')

390 400

406

407

408

409

410

U.S. ROUTE 7

SHELburne ROAD

MATCH TO PLAN DRAWING NO. 19, STA. 411+00

(R)P53/VZ104A
34737

(E)P45-01/VZ102A
102024

(R)P46E/VZ102E
Install Remove

(TOPPED)P45/VZ102
Install Remove

(R)P53/VZ104A
Install Remove

(E)P45-01/VZ102A
Install Remove

(E)P47E/VZ103E
Install Remove

50' #2 POLE
1-SQL X-ARM
110' OF 3# 477
PRI & 4/0
NEUT
1-NEUT BKT
NOTE: SEE
SHEET 16 FOR
INSTALL (R)P53

35' POLE
1-DBL X-ARM
158' OF 3# 336
PRI & 4/0
NEUT
1-5" PRI RISER
3-CO/ARR
1-NEUT BKT
1-GMP ANCH &
GUY

3-CO @ 100K
FUSES & ARR
1-5" 3# PRI
RISER

TOP 45' POLE
1-DBL X-ARM
DBL D.E.
W/JUMP
137' OF 3# 336
PRI & 4/0
NEUT & FLY
TAPS
1-ANCH &
2-GUYS

REMOVE OH
TEMP. SERVICE
... IF REMAINING
STILL
1-NEUT BKT
NOTE: POLE
AND EQUIP. WAS
REMOVED ON
JOB ITEM #
86124

NOTE: STUB
POLE, LIGHT &
SEC WILL BE
REMOVED LATER.

ALLSON PARTNERSHIP

#1600 - 1580

MDT PARTNERSHIP

GREEN MOUNTAIN DRIVE

(E)MTC-1
Install Remove

(E)PAD-1
Install Remove

3-INSUL CAPS
290' OF 3# 1/0
UNG PRI &
NEUT
3-LB ELBOWS

235' OF 3# 1/0
PRI & NEUT
3-LB ELBOWS
NOTE: PHASE
OUT AS REQ'D.

(E)PAD 1
#A6183
150KVA

D
45
4281

(E)MTC-1

SHEET 278 OF 283

| | | | |
|---|-----------------------------|-----------------|------------------|
| | | | |
| GREEN MOUNTAIN POWER CORPORATION SOUTH BURLINGTON, VERMONT | | | |
| 12470Y 4W 3PH FEEDER | | | |
| 32G4 OVERHEAD | | | |
| SHELburne ROAD RECONSTRUCTION | | | |
| DRAWN: LAW | CHECKED: MM | APPROVED: WH | SCALE: 1"=20' |
| DATE: 7-18-02 | DRAWING NO. PL-29-3-4-19 | SHEET: 18A | |

ROUTE 7 "PHASE-1" JOB ITEM # ARE-00712-86423
DRAWINGS/DISTRIB./ROUTE/RECEIVED 3-4-02/A0054591101