

TYPICAL U.S. 7 SECTIONS


EMULSION ASPHALT, ITEM 404.65, SHALL BE APPLIED BETWEEN ALL LIFTS OF PAVEMENT AT A MAXIMUM RATE OF 0.15 Gal./S.Y.

- 2" SUPERPAVE BITUMINOUS CONCRETE PAVEMENT (PG 70-28), ITEM 490.30, WEARING COURSE, TYPE III S
- 3" SUPERPAVE BITUMINOUS CONCRETE PAVEMENT (PG 70-28), ITEM 490.30, BINDER COURSE, TYPE II S
- 4" SUPERPAVE BITUMINOUS CONCRETE PAVEMENT (PG 70-28), ITEM 490.30, BASE COURSE, TYPE I S
- 30" SUBBASE OF DENSE GRADED CRUSHED STONE, ITEM 301.35
- 15" SAND BORROW, ITEM 203.31

ALIGNMENT DEFINITIONS:
 STATION LINE (§) REPRESENTS DESIGN LINE OF ROADWAY
 CENTERLINE (⊕) REPRESENTS THE CENTER OF THE HISTORIC (1797) ROW

PT 377+88.32 TO STA. 380+78
 STA. 383+69 TO STA. 387+64
 STA. 390+30 TO STA. 395+34


STA. 405+83 TO STA. 410+50
 STA. 412+23 TO STA. 416+55

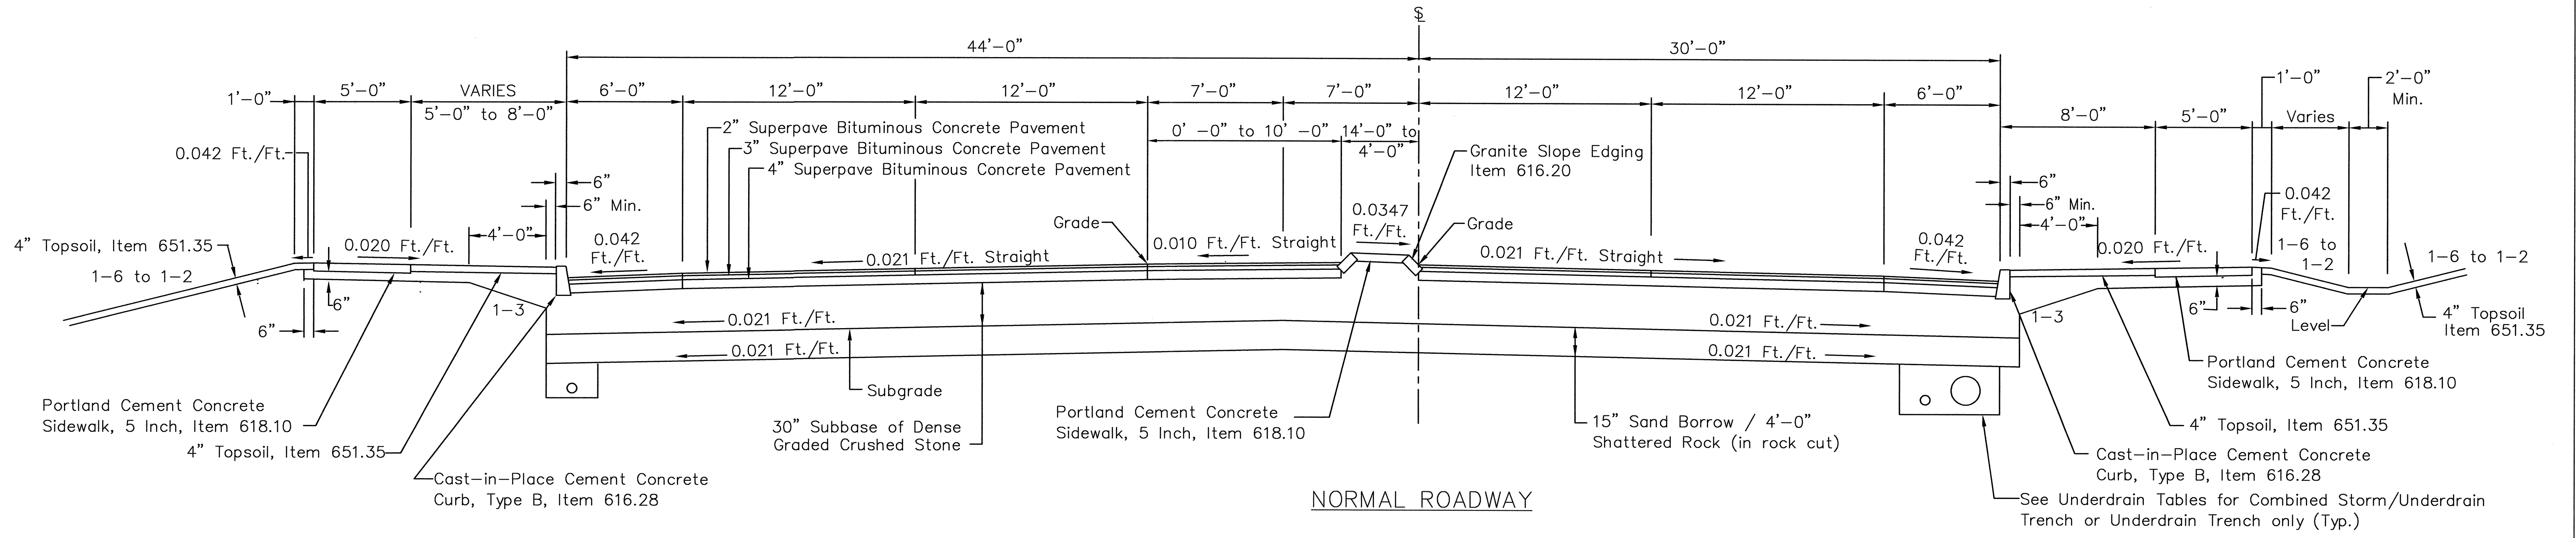

NORMAL ROADWAY

STA. 380+78 TO STA. 383+69
 STA. 387+64 TO STA. 390+30

STA. 401+49 TO STA. 405+83
 STA. 410+50 TO STA. 412+23
 STA. 420+05 TO STA. 423+15

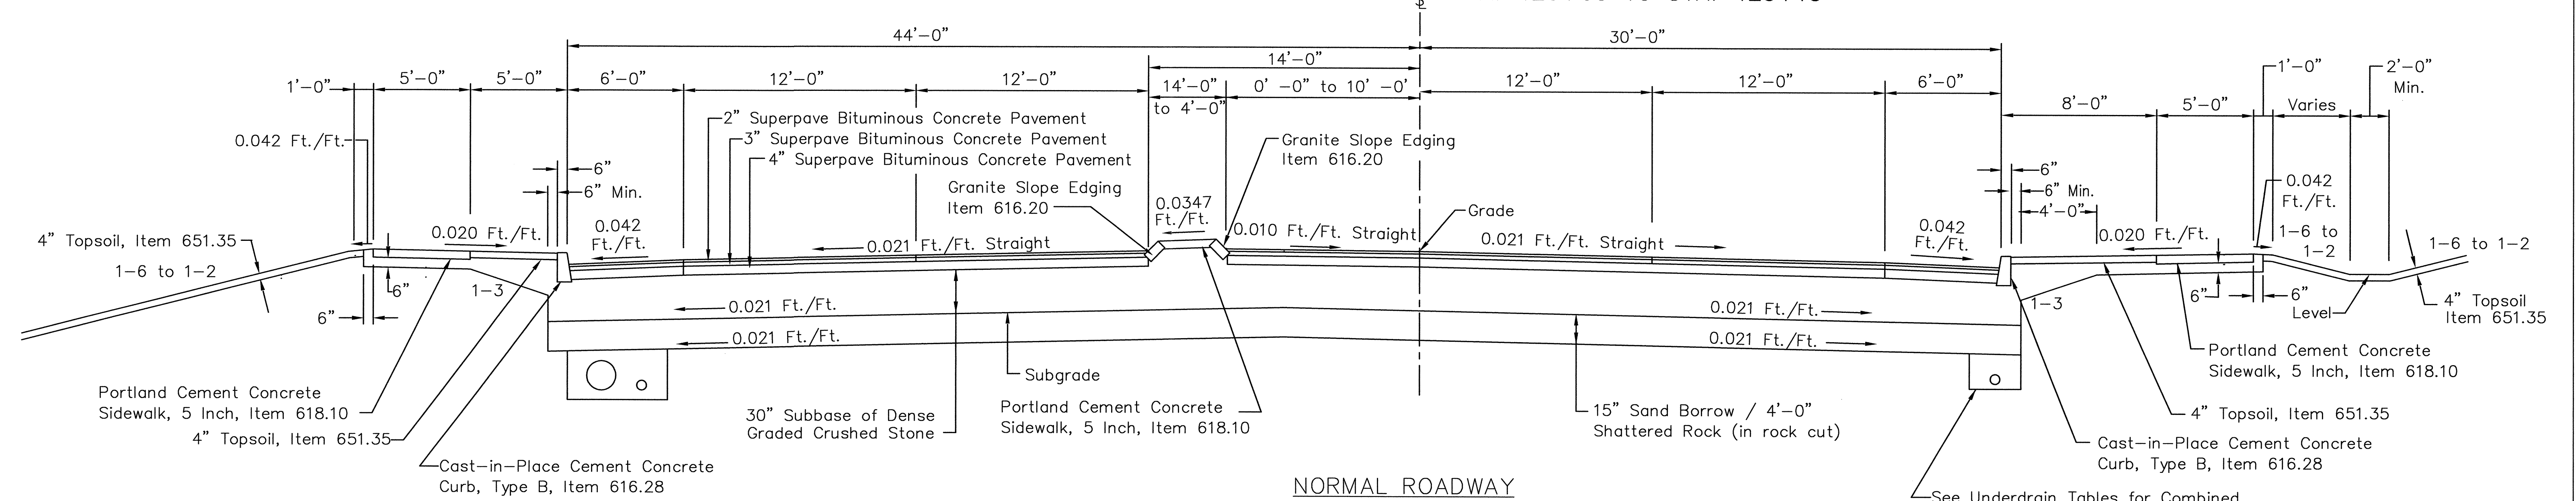

NORMAL ROADWAY

For Drainage & Underdrain Details
 See Typical Section Dwg. No. 7

For General Notes, Curb & Underdrain Details
 See Typical Section Dwg. No. 7

For Ditch Details & Bus Stop Typical
 See Typical Section Dwg. No. 7

SCALE - 1/4" = 1.0'

See Underdrain Tables for Combined Storm/Underdrain Trench or Underdrain Trench only (Typ.)

THICKNESS TOLERANCES
 PAVEMENT 1/4" Total
 SUBBASE 1" Total
 SELECT MATERIAL 1" Total

SHELBURNE - SOUTH BURLINGTON

SURVEYED BY Y.S.C. INC. DATE _____
 DRAWN BY E.A.A. INC. DATE _____
 TRACED BY E.A.A. INC. DATE _____

PROJECT NH-EGC-019-4(28)
 TYPICAL SECTION DRAWING NO. 3
 SHEET NO. 6 OF 283

DATUM
 VERTICAL NGVD 1929
 HORIZONTAL NAD 1927

4/4/03

K:\033008 US Rte 7 Shelburne\033008.dwg, 9/5/2006 1:18:18 PM, jamaica, VT-BRL-HP (05cm East/Paper-Final).pc3