


DATUM  
 VERTICAL NGVD 1929  
 HORIZONTAL NAD 1927

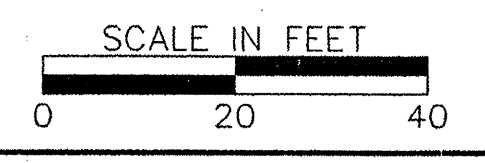

<b>R.O.W. PLAN</b>  THIS SHEET TO BE USED FOR R.O.W. INFORMATION ONLY.	SURVEYED BY V.S.C. INC. DATE _____ DRAWN BY E.A.A. INC. DATE _____ TRACED BY E.A.A. INC. DATE _____
	PROJECT F-EGC-019-4(19) R.O.W. DRAWING NO. 27 SHEET NO. 24 OF 283

C.O.#11, 4/19/02