

MATCH TO R.O.W. PLAN DRAWING NO. 31, STA. 417+00


MATCH TO R.O.W. PLAN DRAWING NO. 33, STA. 423+00

CRANE, EDWARD B., Trustee,  
EDWARD B. CRANE LIVING TRUST, Owner & Lessor  
HERSHBERG, EDWIN M. &  
DAVID, Lessees

CRANE, EDWARD B., Trustee,  
EDWARD B. CRANE LIVING TRUST

TWO O'BRIENS PROPERTIES, LLC

SOCINSKI, ANTHONY A.

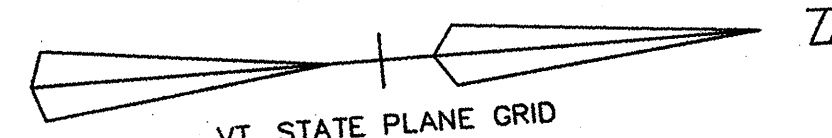


DATUM  
VERTICAL NGVD 1929  
HORIZONTAL NAD 1927

**CONSTRUCT DRIVE**  
417+34 LT - 24'  
418+79 LT - 24'  
420+89 LT - 35'

**DEMOLITION & DISPOSAL OF:**  
D85 @ 417+95, LT (SIGN & PLANTER)  
D86 @ 419+25, LT (SIGN, LP & LANDSCAPING)  
D98 @ 422+83, RT (ELECTRICAL PANEL)  
D102 @ 419+90, LT (SIGN & 2 GLs)  
D139 @ 421+20, LT (SIGN)

**CONSTRUCT APPROACH**  
JUGHANDLE H 420+00.00 RT

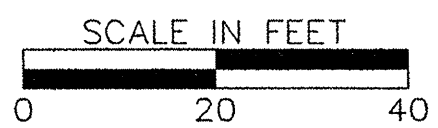

**R.O.W. PLAN**  
THIS SHEET TO BE USED  
FOR R.O.W. INFORMATION ONLY.

SURVEYED BY V.S.C. INC. DATE \_\_\_\_\_  
DRAWN BY E.A.A. INC. DATE \_\_\_\_\_  
TRACED BY E.A.A. INC. DATE \_\_\_\_\_

PROJECT F-EGC-019-4(19)  
R.O.W. DRAWING NO. 32  
SHEET NO. 29 OF 283