


MATCH TO R.O.W. DRAWING NO. 09

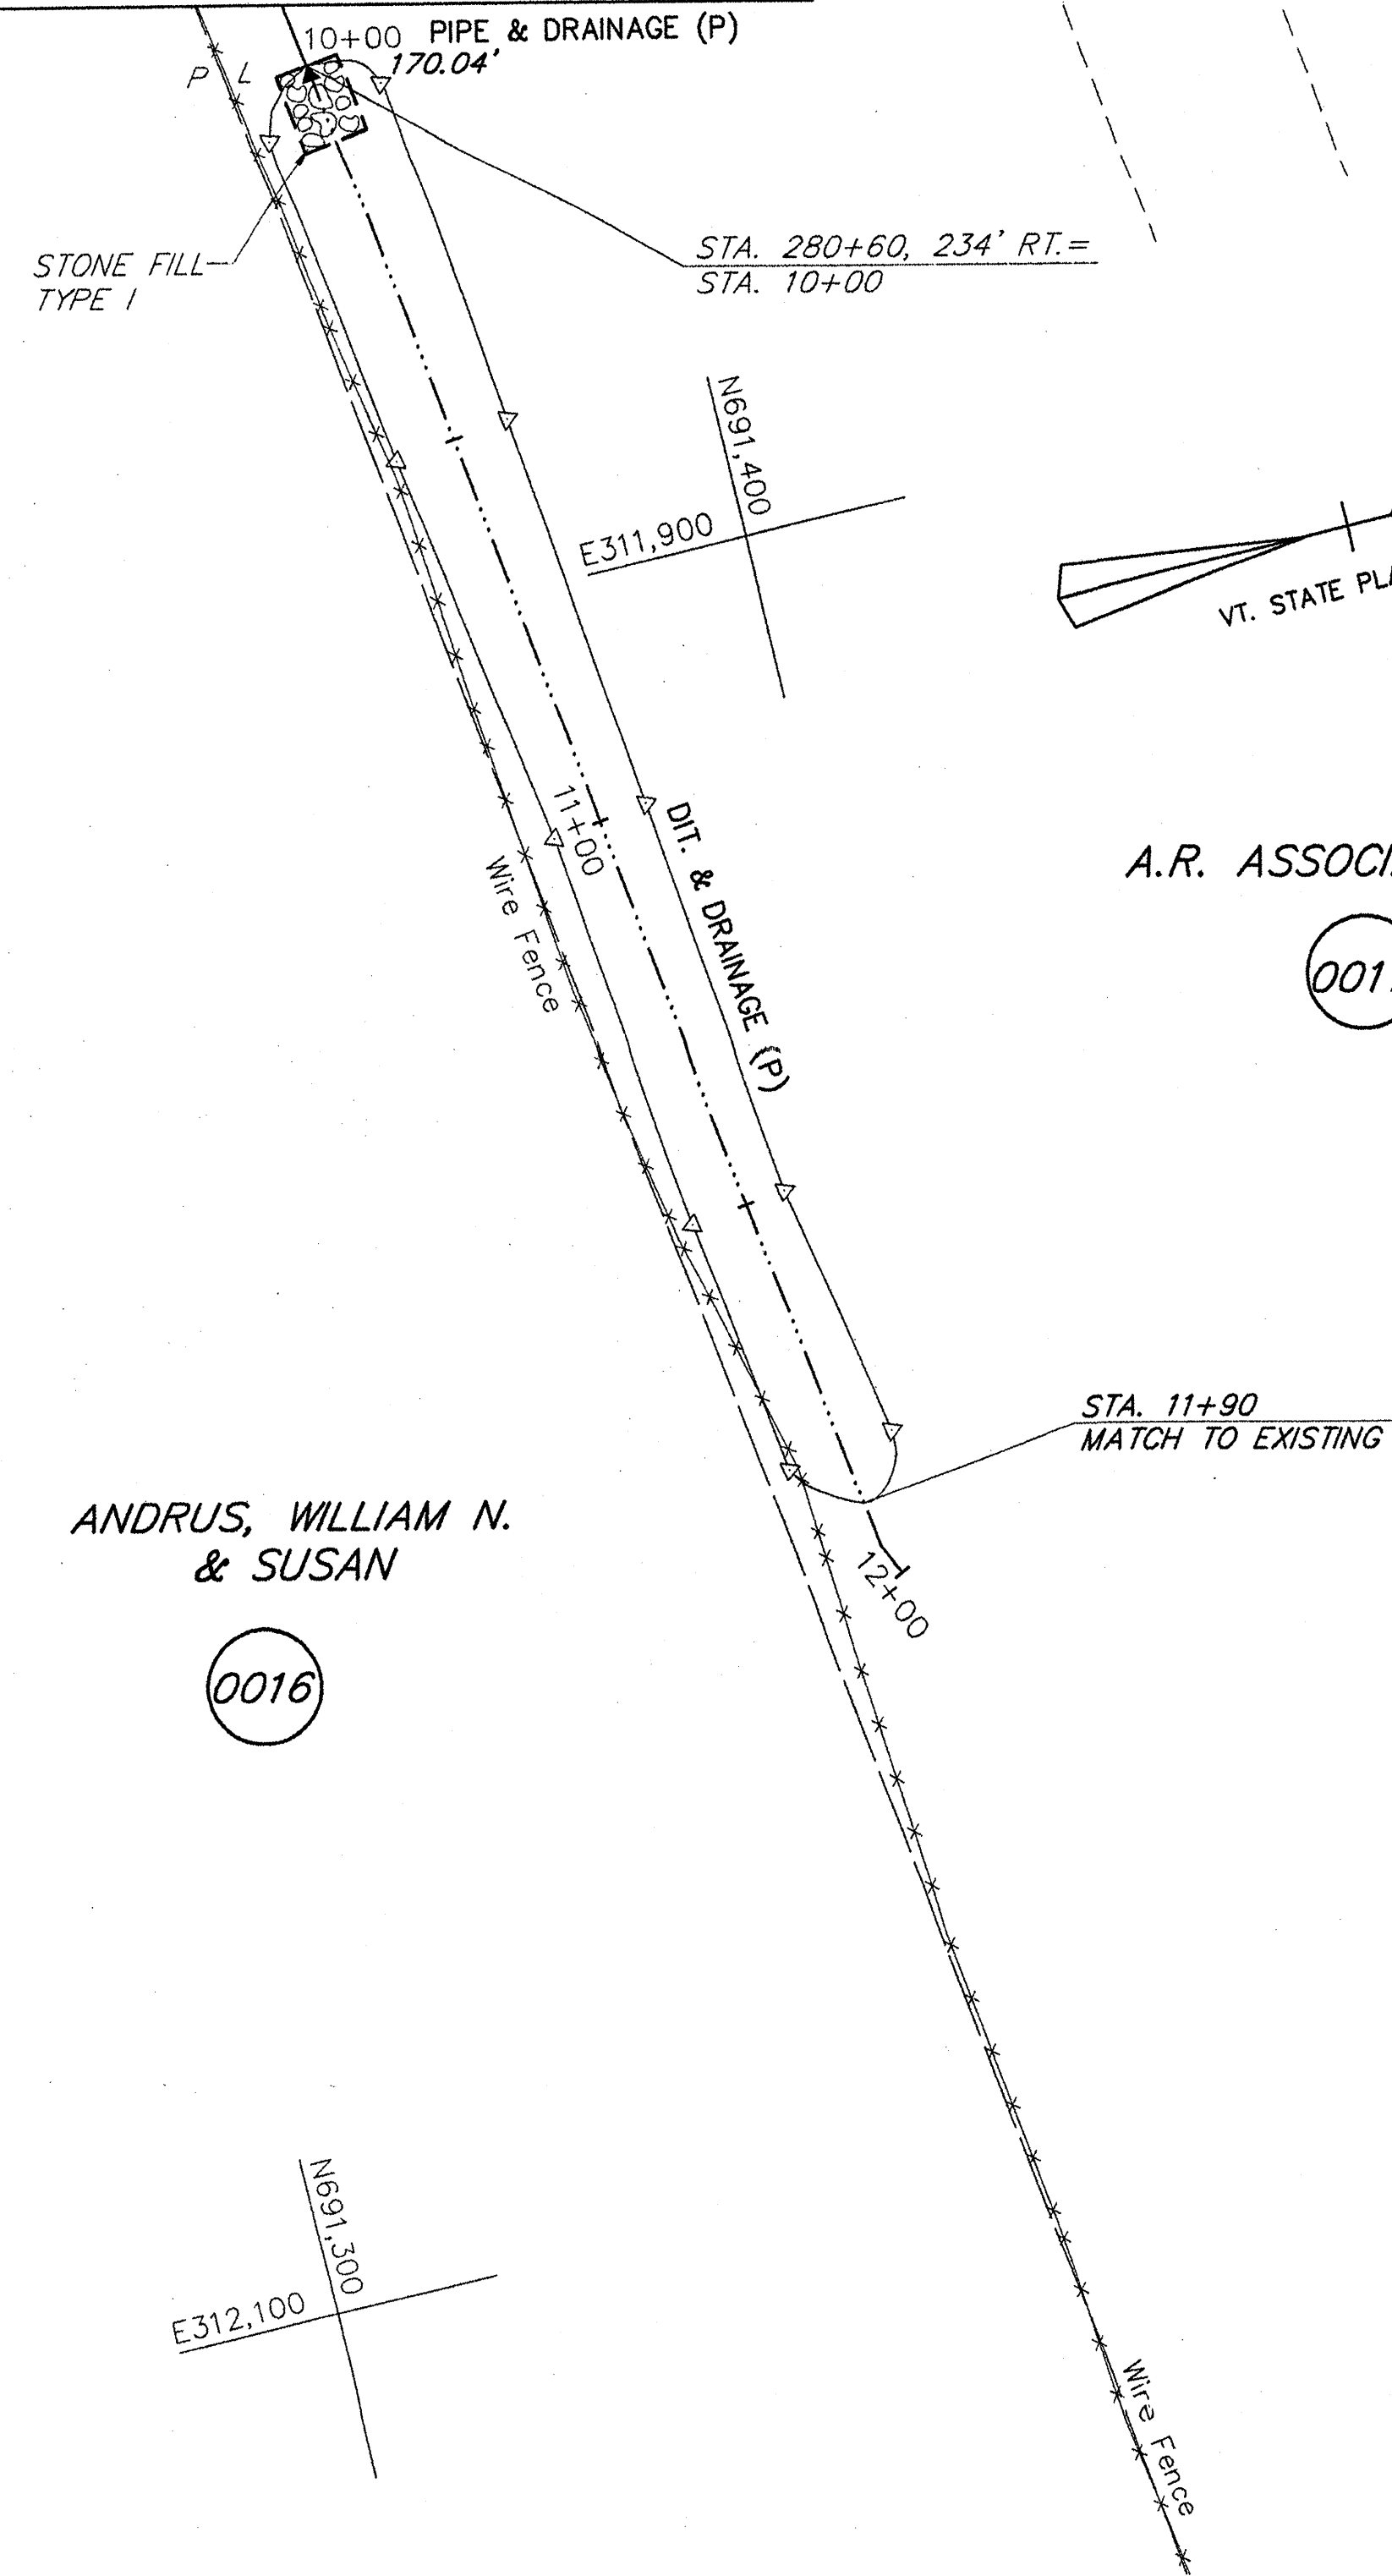


A.R. ASSOCIATES, INC.


0017

ANDRUS, WILLIAM N.
& SUSAN

0016

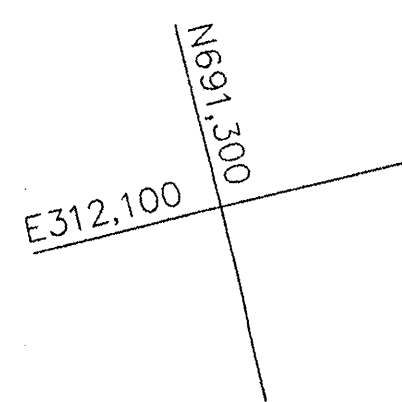


DATUM
VERTICAL NGVD 1929
HORIZONTAL NAD 1927

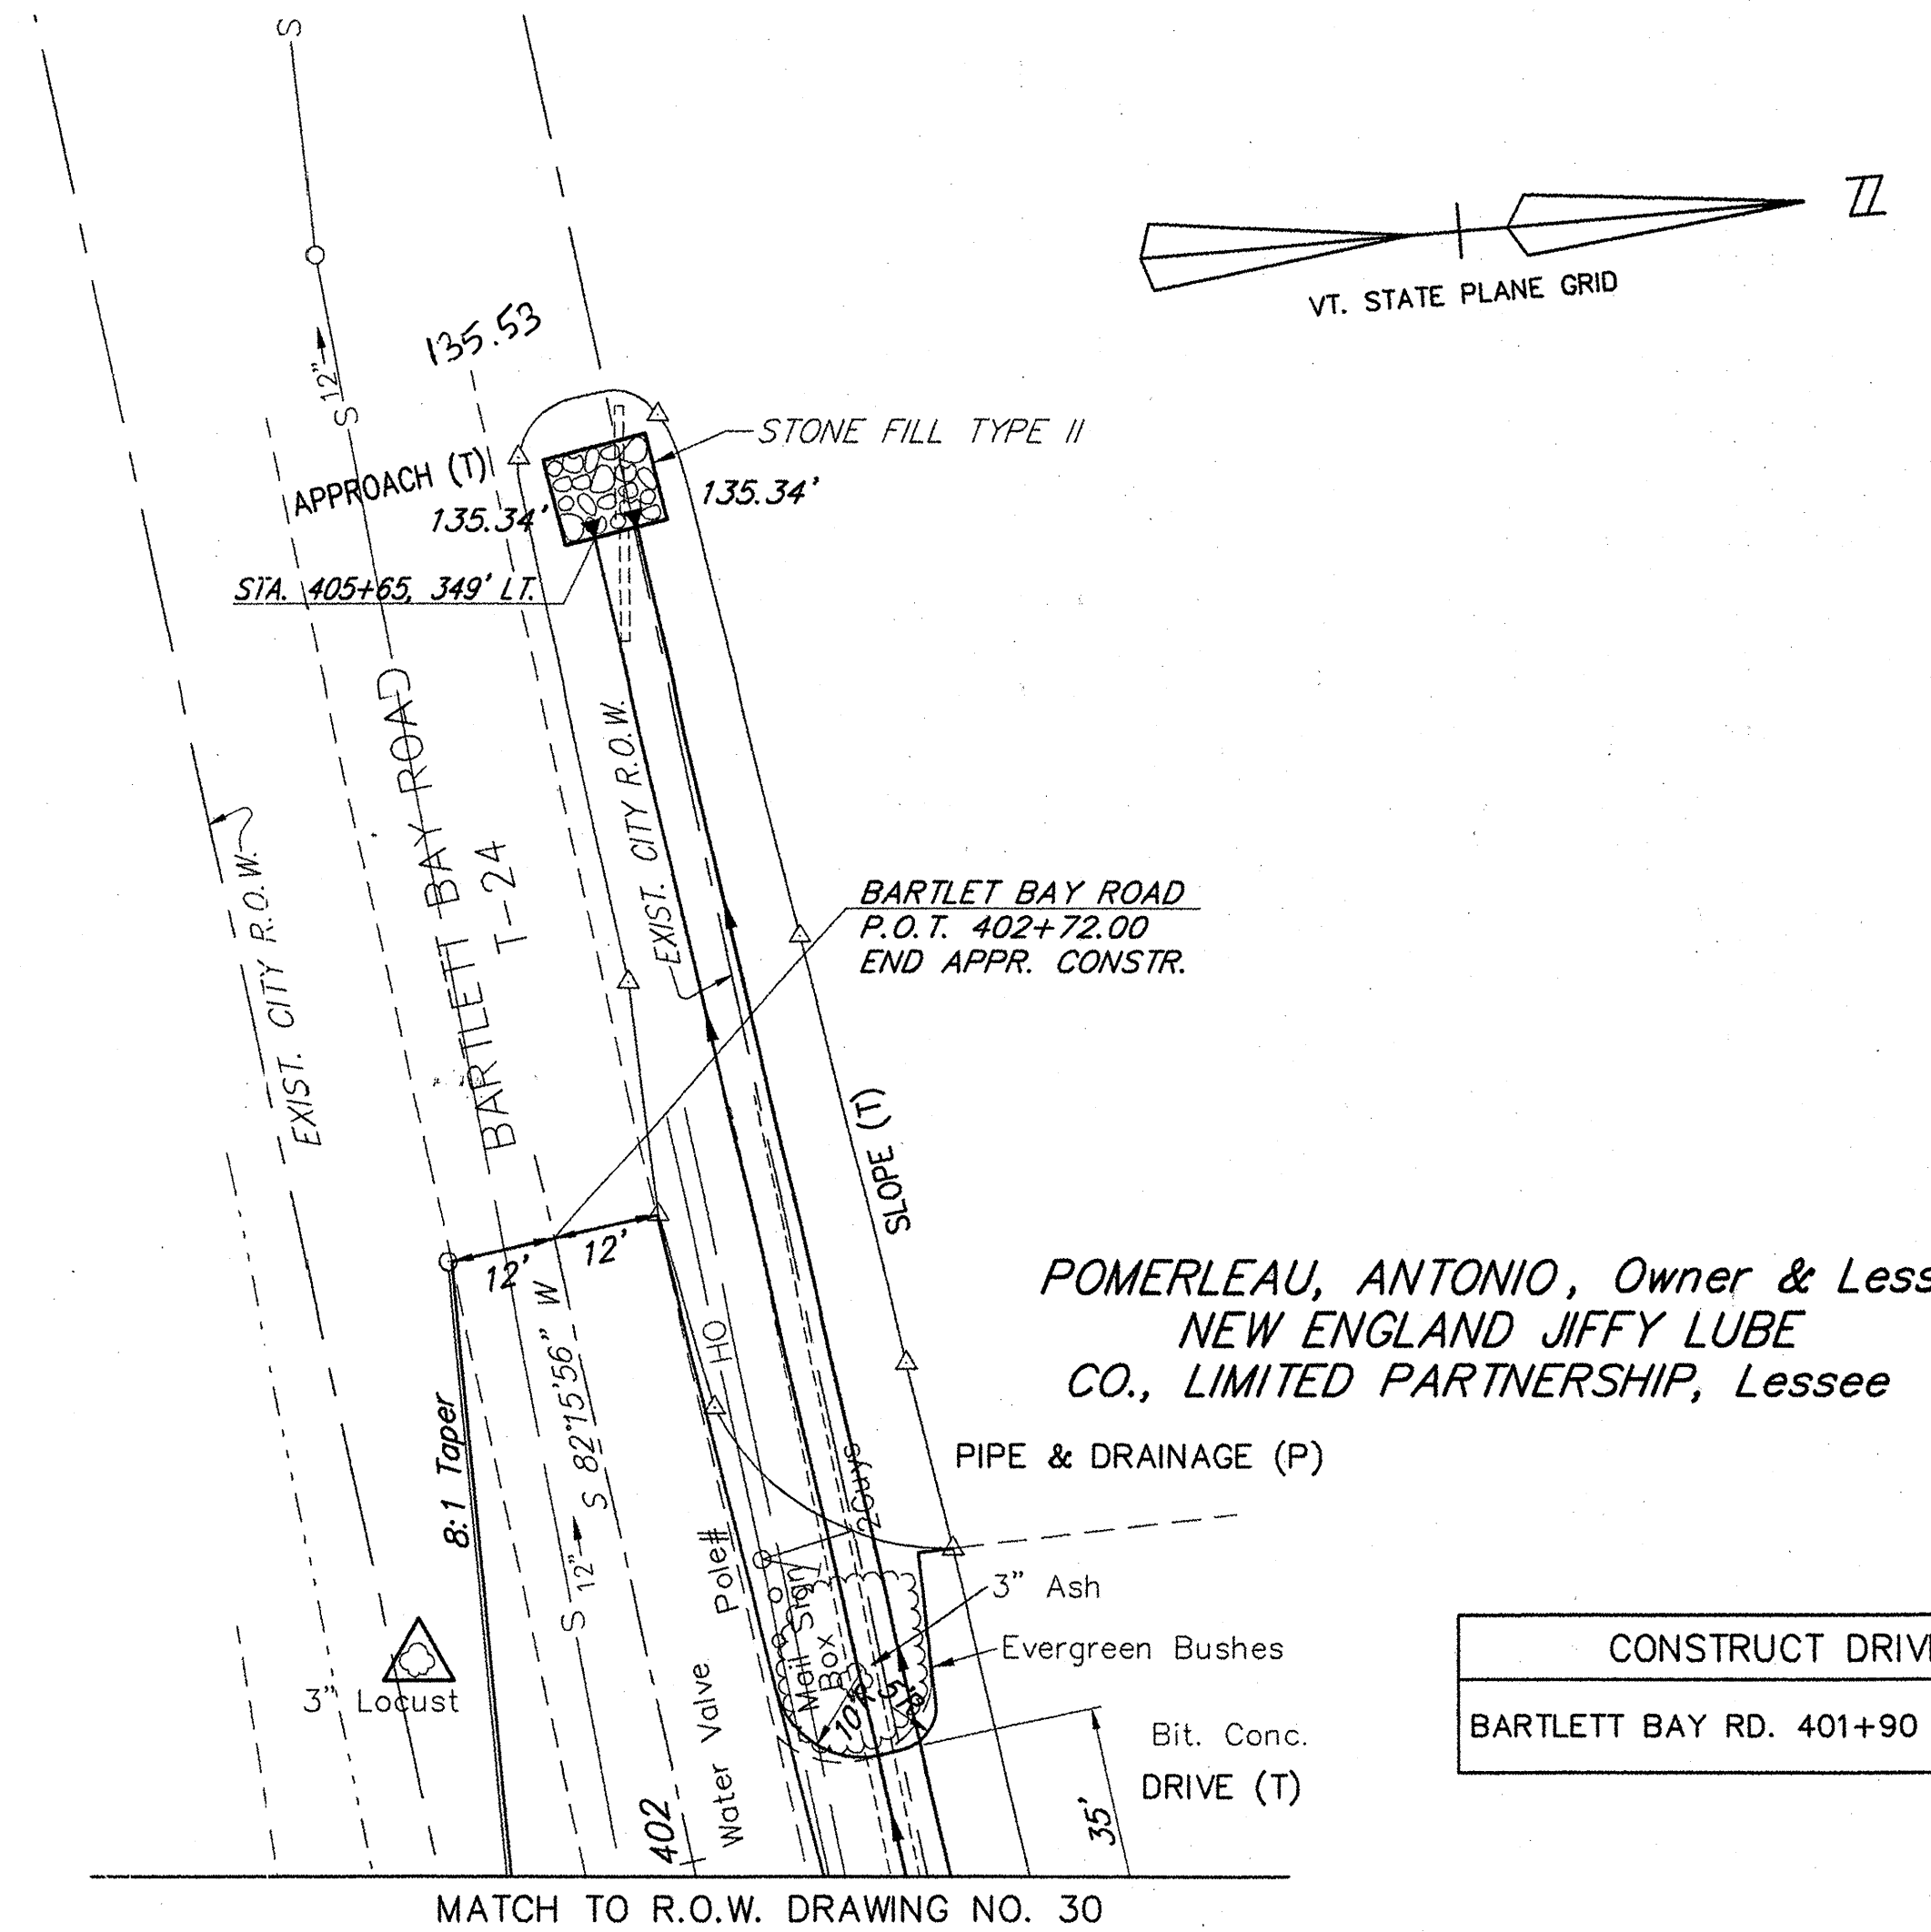

POMERLEAU, ANTONIO, Owner & Lessor,
NEW ENGLAND JIFFY LUBE
CO., LIMITED PARTNERSHIP, Lessee

CONSTRUCT DRIVE
BARTLETT BAY RD. 401+90 RT - 35'

MATCH TO R.O.W. DRAWING NO. 30

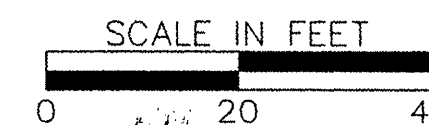

R.O.W. PLAN

THIS SHEET TO BE USED
FOR R.O.W. INFORMATION ONLY.

SHELburne - SOUTH BURLINGTON

SURVEYED BY V.S.C. INC. DATE _____
DRAWN BY E.A.A. INC. DATE _____
TRACED BY E.A.A. INC. DATE _____

PROJECT F-EGC-019-4(19)
R.O.W. DRAWING NO. 34
SHEET NO. 31 OF 283

C.O.#11, 4/19/02