



PLAN
 SURVEYED _____ DATE _____
 ALIGNED _____
 ALIGNMENT CHECKED _____
 RT. OF WAY CHECKED _____
 NOTE BOOK NO. _____

PROFILE
 SURVEYED _____ DATE _____
 ALIGNED _____
 ALIGNMENT CHECKED _____
 STRUCTURE NOTATION CHECKED _____
 NOTE BOOK NO. _____

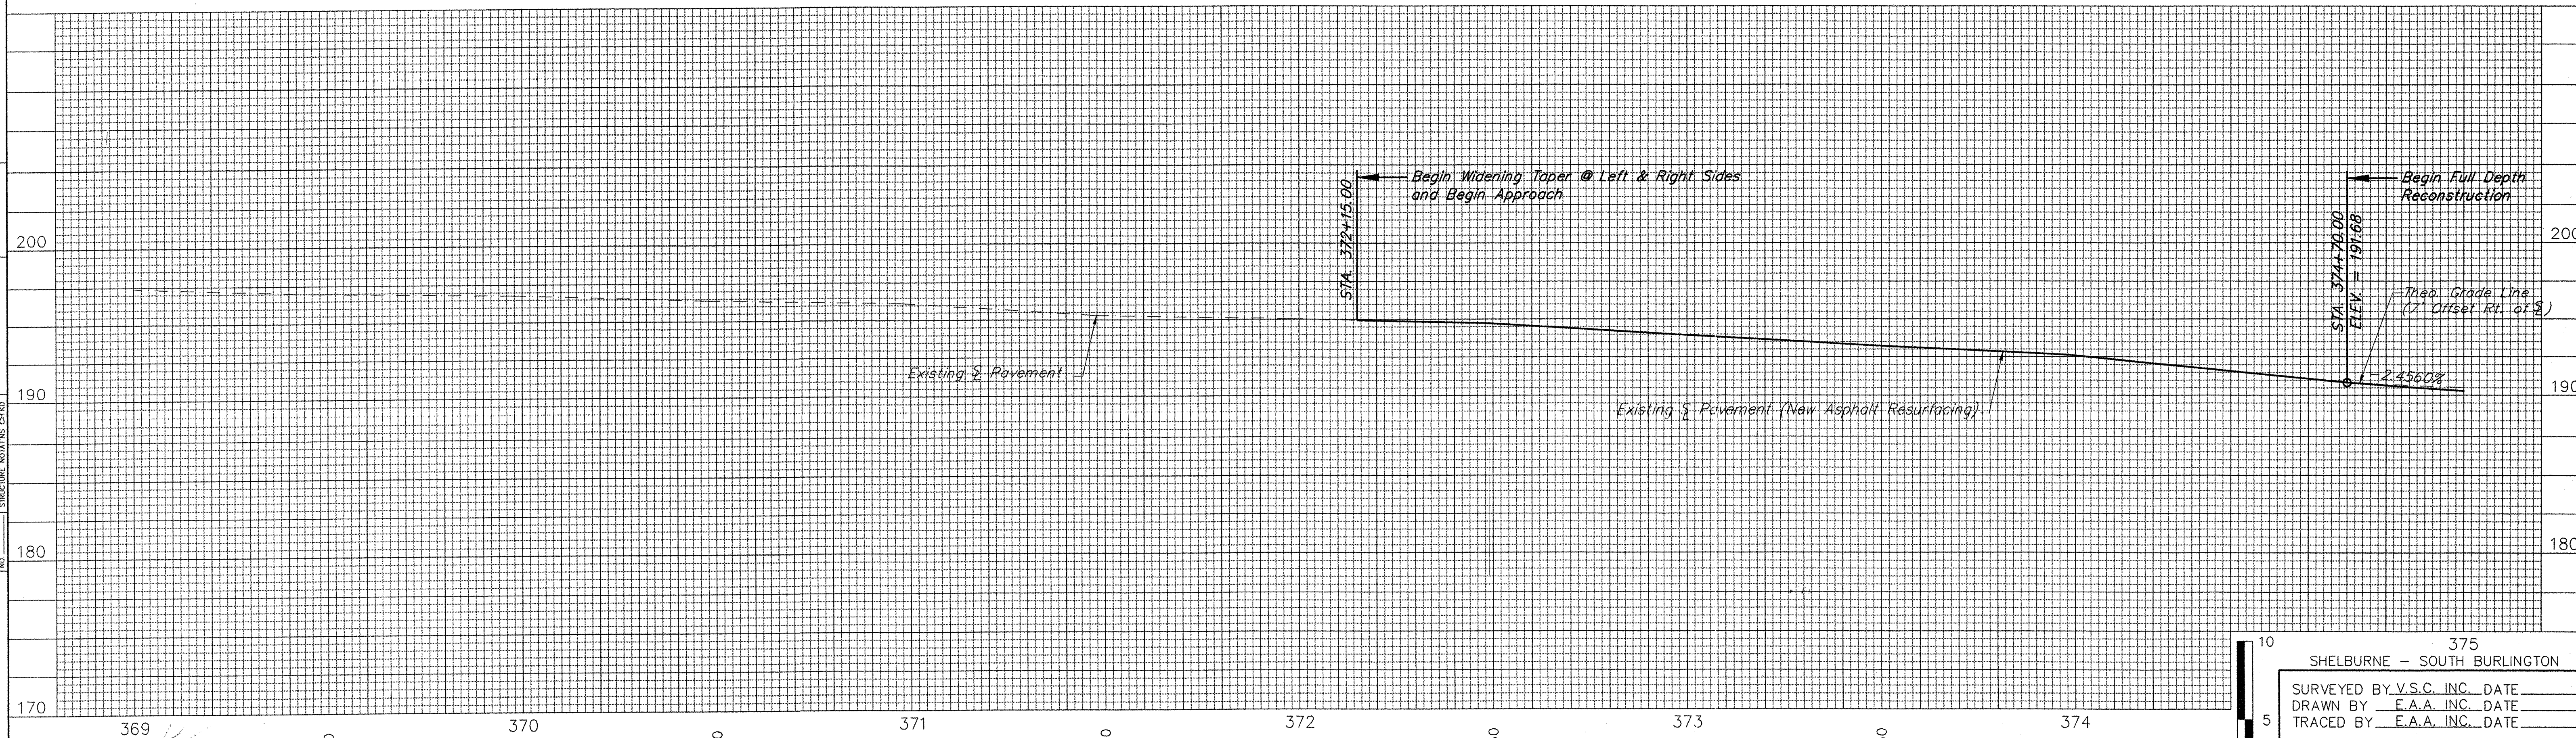

DATUM
 VERTICAL NGVD 1929
 HORIZONTAL NAD 1927

4/4/03 FOR PLAN SEE PLAN DRAWING NO. 1

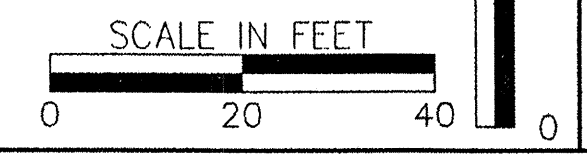

375
 SHELburne - SOUTH BURLINGTON
 SURVEYED BY V.S.C. INC. DATE _____
 DRAWN BY E.A.A. INC. DATE _____
 TRACED BY E.A.A. INC. DATE _____
 PROJECT NH-EGC-019-4(28)
 PROFILE DRAWING NO. 1
 SHEET NO. 80 OF 283