



DATE _____
 BY _____
 SURVEYED BY V.S.C. INC. DATE _____
 GRADES CHECKED BY E.A.A. INC. DATE _____
 NOTE BOOK NO. _____
 PLAN

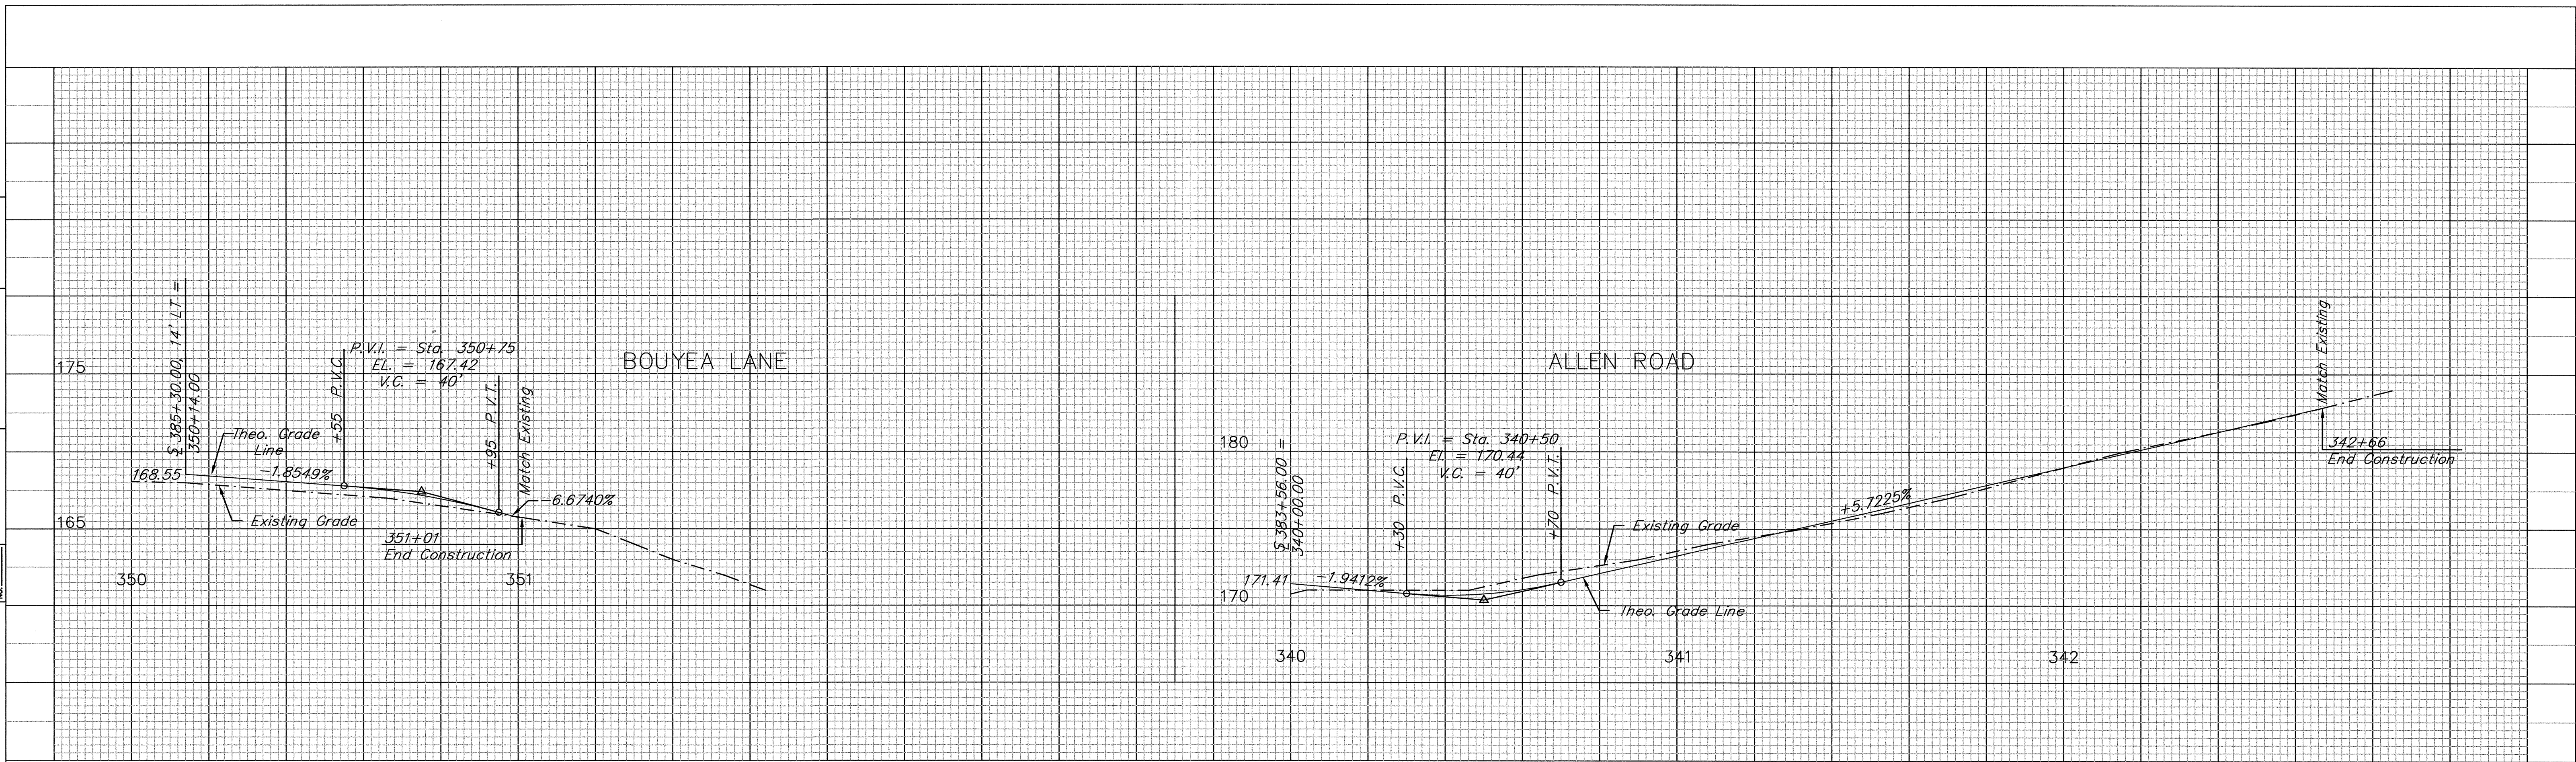

DATE _____
 BY _____
 SURVEYED BY V.S.C. INC. DATE _____
 GRADES CHECKED BY E.A.A. INC. DATE _____
 NOTE BOOK NO. _____
 PROFILE

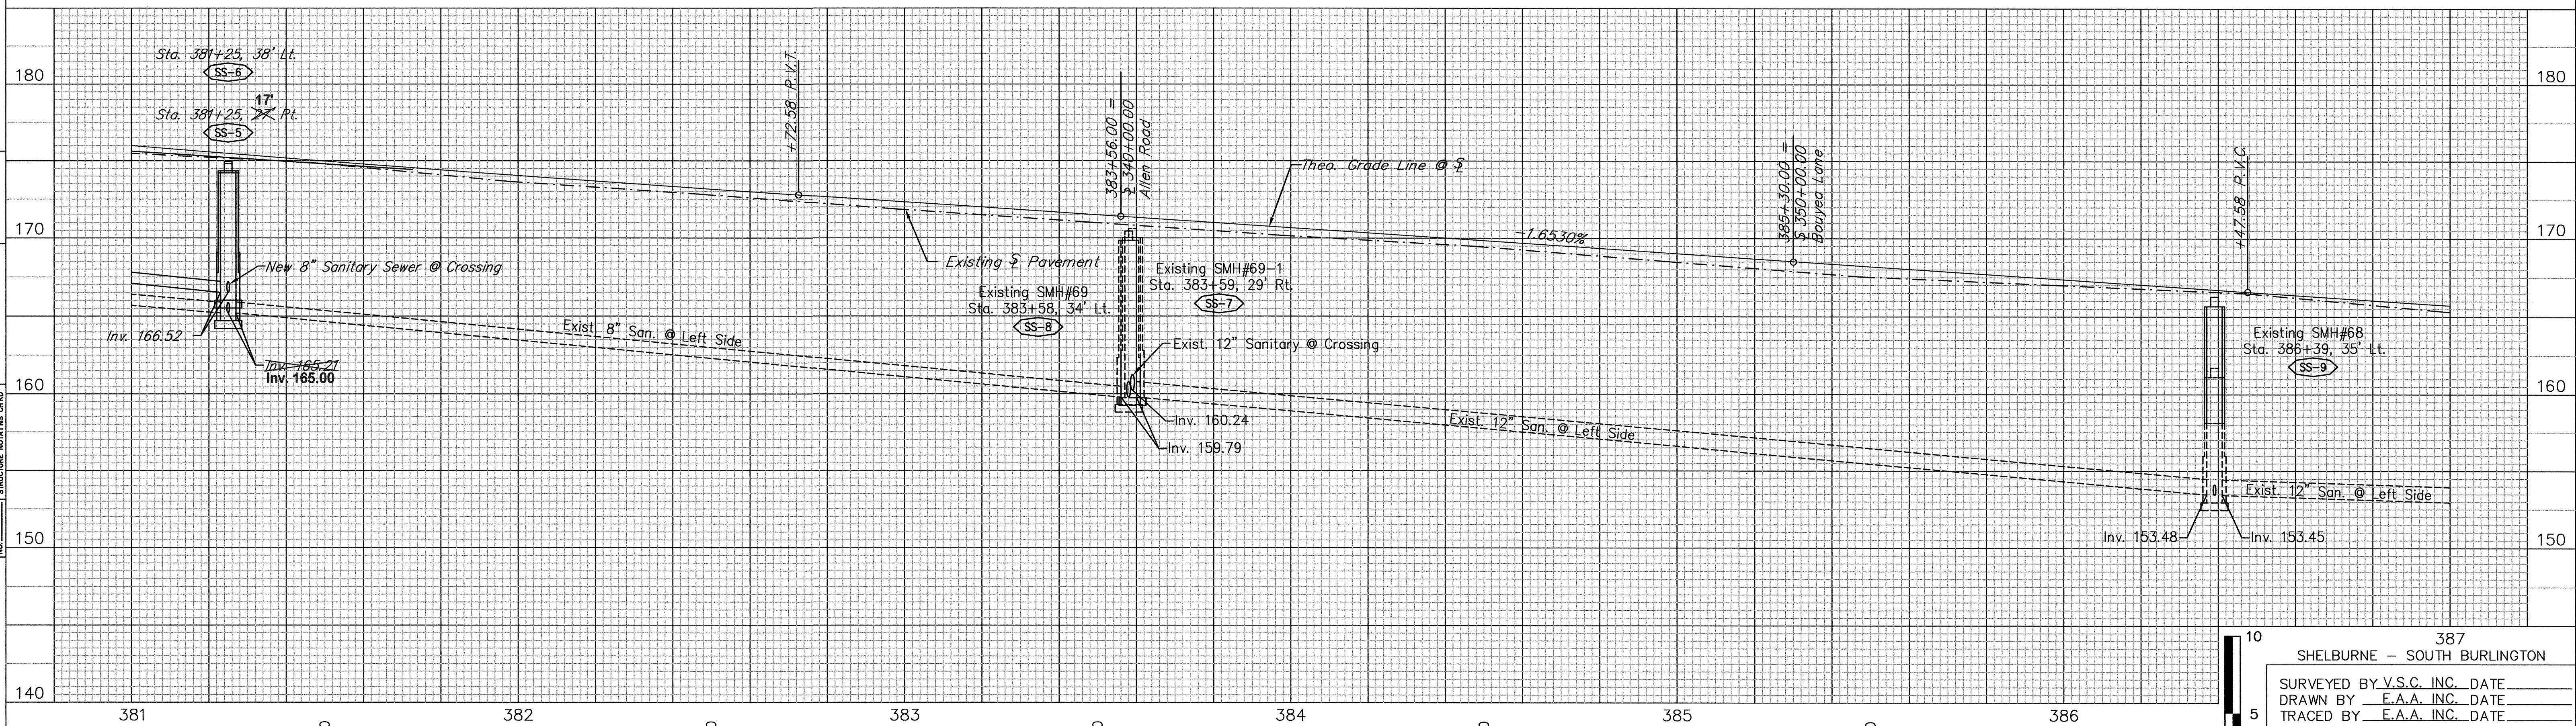


DATUM
 VERTICAL NGVD 1929
 HORIZONTAL NAD 1927

AS-BUILT REVISIONS

NO.	DATE	DESCRIPTION
1.	3/2/06	SEWER EDITS
2.	8/8/06	SEWER TEXT EDITS

FOR PLAN SEE PLAN DRAWING NO. 3

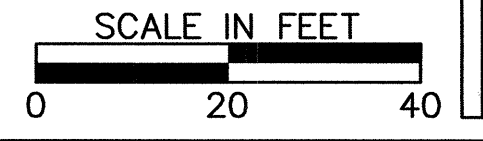

387
 SHELburne - SOUTH BURLINGTON
 SURVEYED BY V.S.C. INC. DATE _____
 DRAWN BY E.A.A. INC. DATE _____
 TRACED BY E.A.A. INC. DATE _____
 PROJECT NH-EGC-019-4(28)
 PROFILE DRAWING NO. 3
 SHEET NO. 82 OF 283