
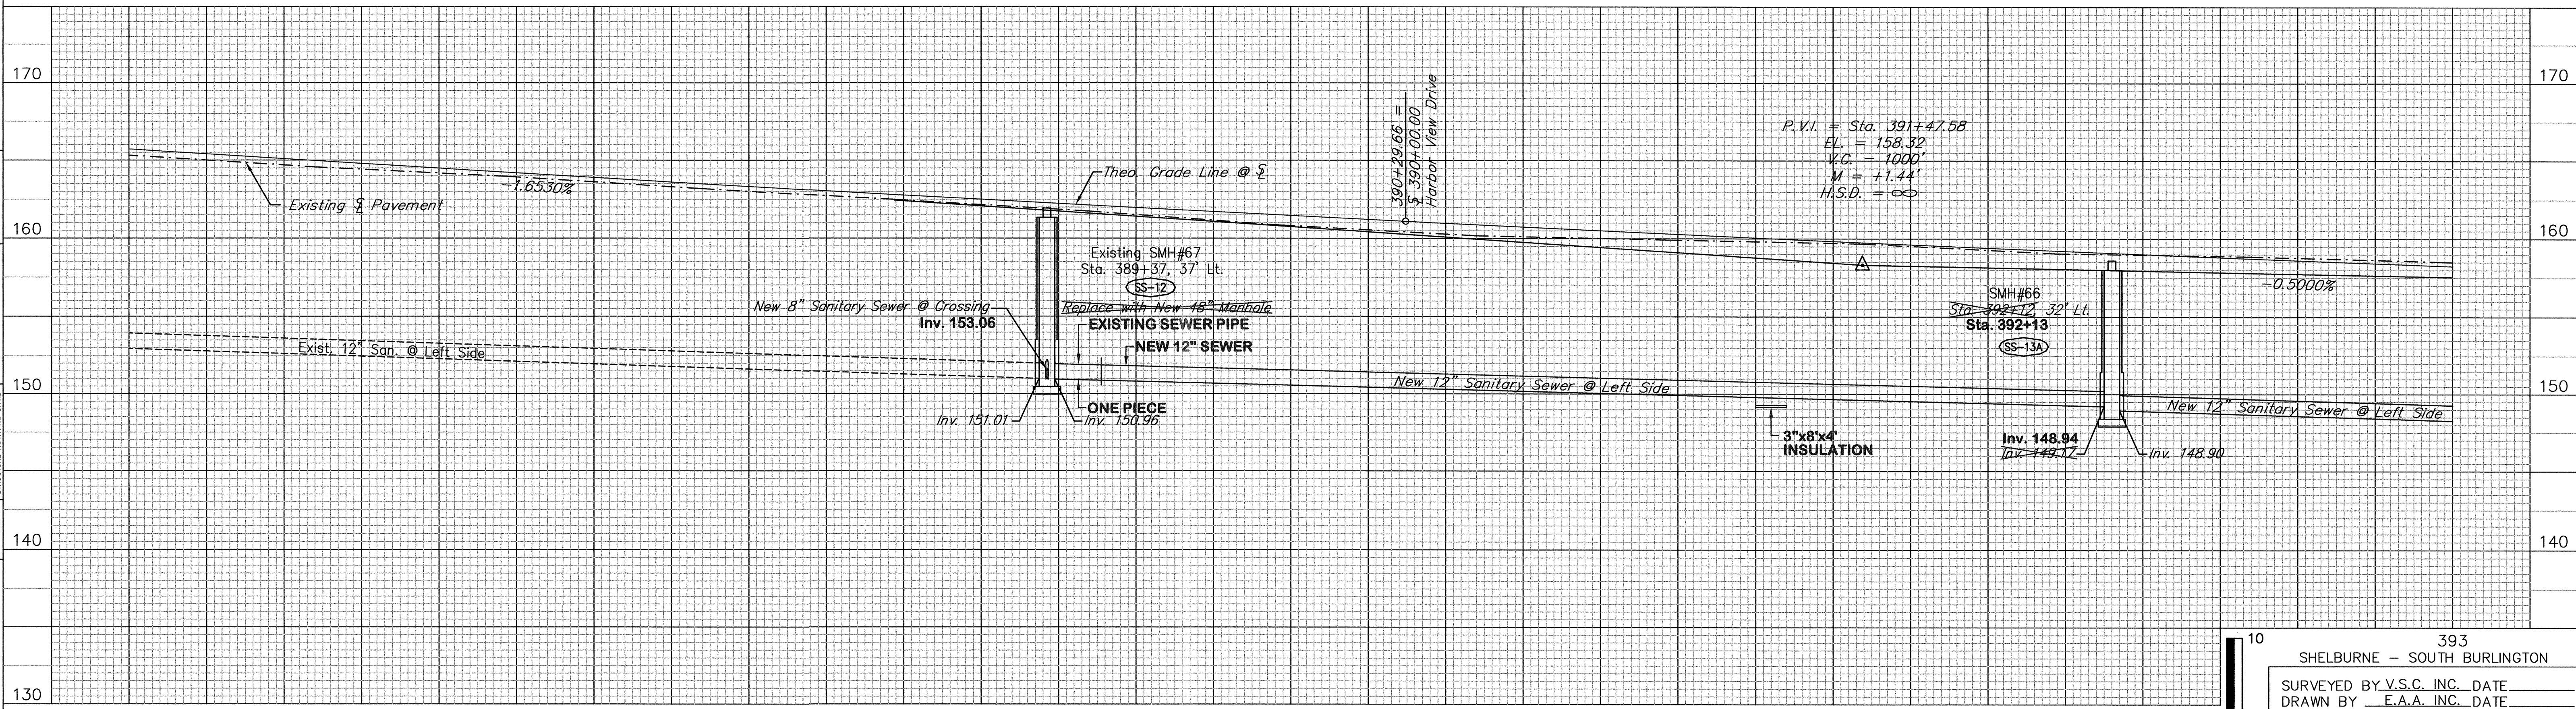


DATE \_\_\_\_\_  
 BY \_\_\_\_\_  
 SURVEYED \_\_\_\_\_  
 PLOTTED \_\_\_\_\_  
 PRINTED \_\_\_\_\_  
 REVISIONS CHECKED \_\_\_\_\_  
 REVISIONS DATE \_\_\_\_\_  
 REVISIONS BY \_\_\_\_\_  
 NOTE BOOK NO. \_\_\_\_\_

DATE \_\_\_\_\_  
 BY \_\_\_\_\_  
 SURVEYED \_\_\_\_\_  
 PLOTTED \_\_\_\_\_  
 PRINTED \_\_\_\_\_  
 REVISIONS CHECKED \_\_\_\_\_  
 REVISIONS DATE \_\_\_\_\_  
 REVISIONS BY \_\_\_\_\_  
 NOTE BOOK NO. \_\_\_\_\_

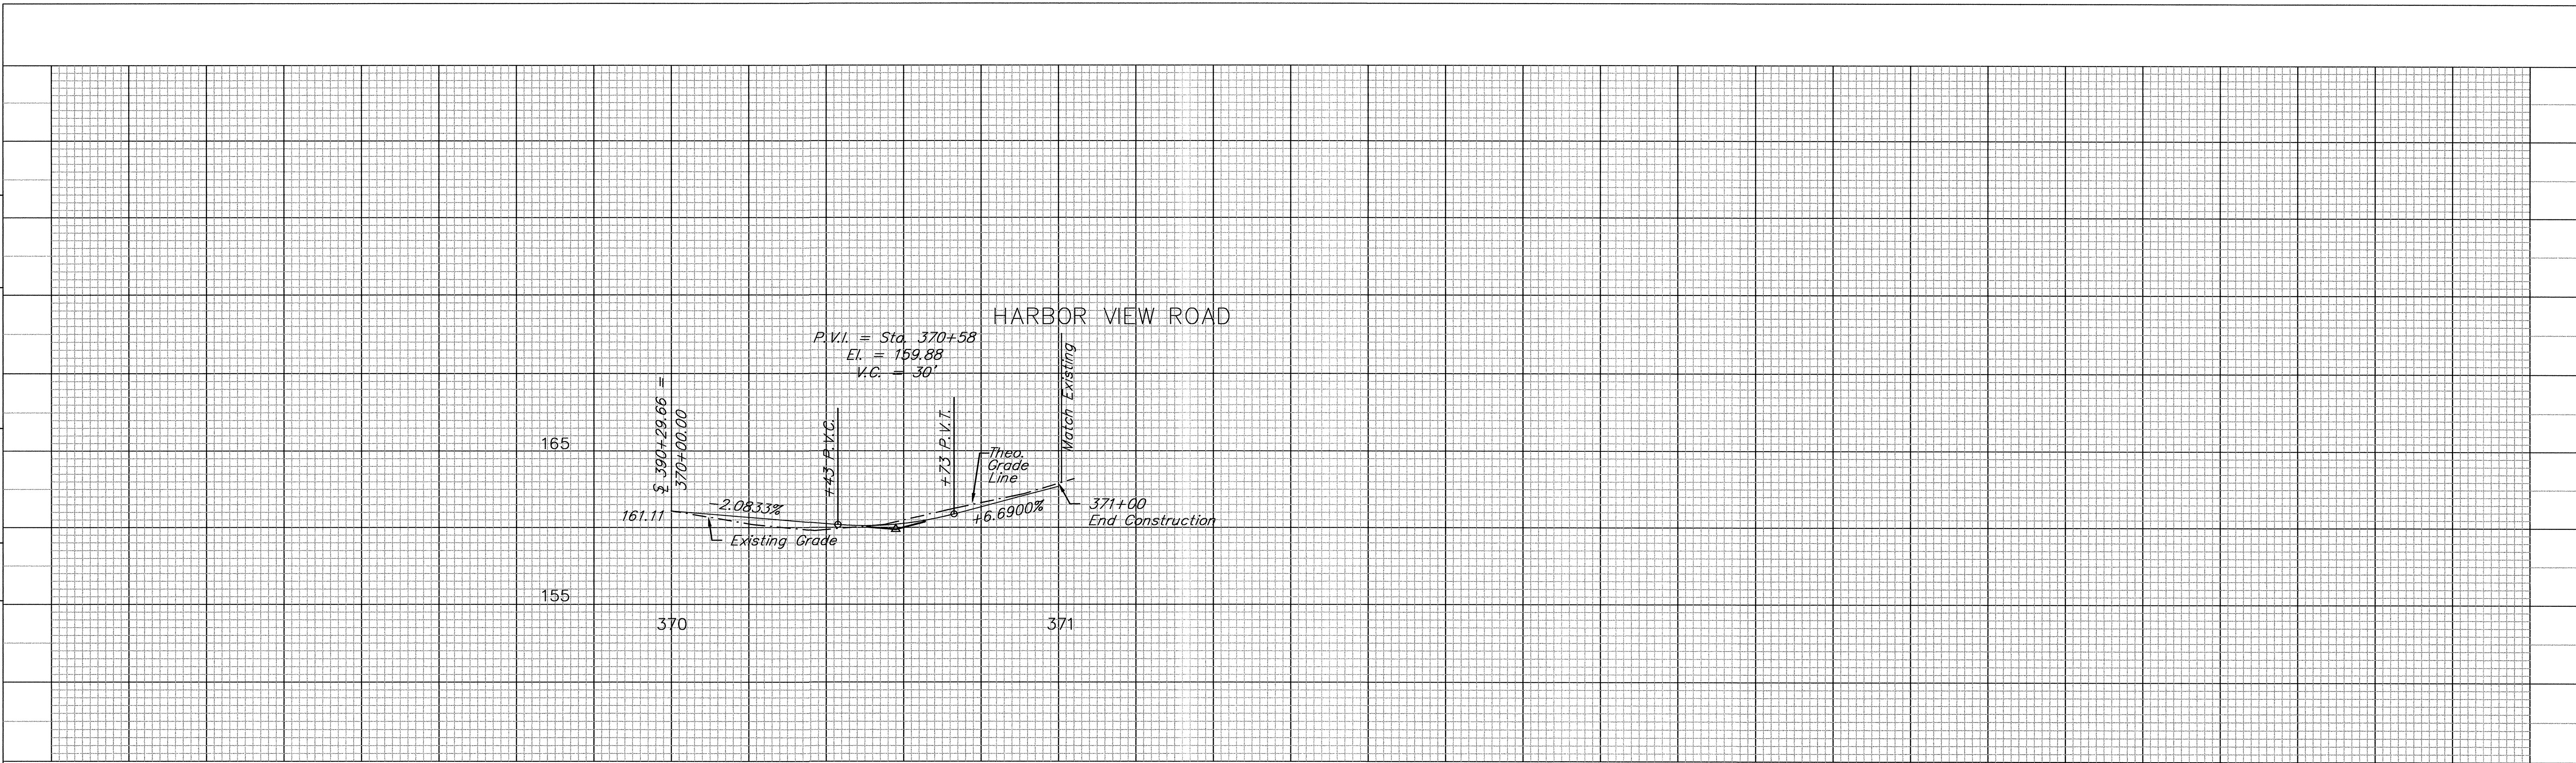

DATUM  
 VERTICAL NGVD 1929  
 HORIZONTAL NAD 1927

AS-BUILT REVISIONS		
NO.	DATE	DESCRIPTION
1.	3/2/06	SEWER EDITS

FOR PLAN SEE PLAN DRAWING NO. 4

REVISSED SEWER DESIGN  
 SCALE IN FEET  
 0 20 40

10  
 5  
 0

393  
 SHELBURNE - SOUTH BURLINGTON

SURVEYED BY V.S.C. INC. DATE \_\_\_\_\_  
 DRAWN BY E.A.A. INC. DATE \_\_\_\_\_  
 TRACED BY E.A.A. INC. DATE \_\_\_\_\_

PROJECT NH-EGC-019-4(28)  
 PROFILE DRAWING NO. 4  
 SHEET NO. 83R OF 283