


DATE _____
 BY _____
 PLAN
 REVISED - _____
 ALIGNED - _____
 NOTE BOOK NO. _____
 NO. _____

DATE _____
 BY _____
 PROFILE
 REVISED - _____
 GRADE CHECKED - _____
 STRUCTURE NOTATION - _____
 NOTE BOOK NO. _____
 NO. _____

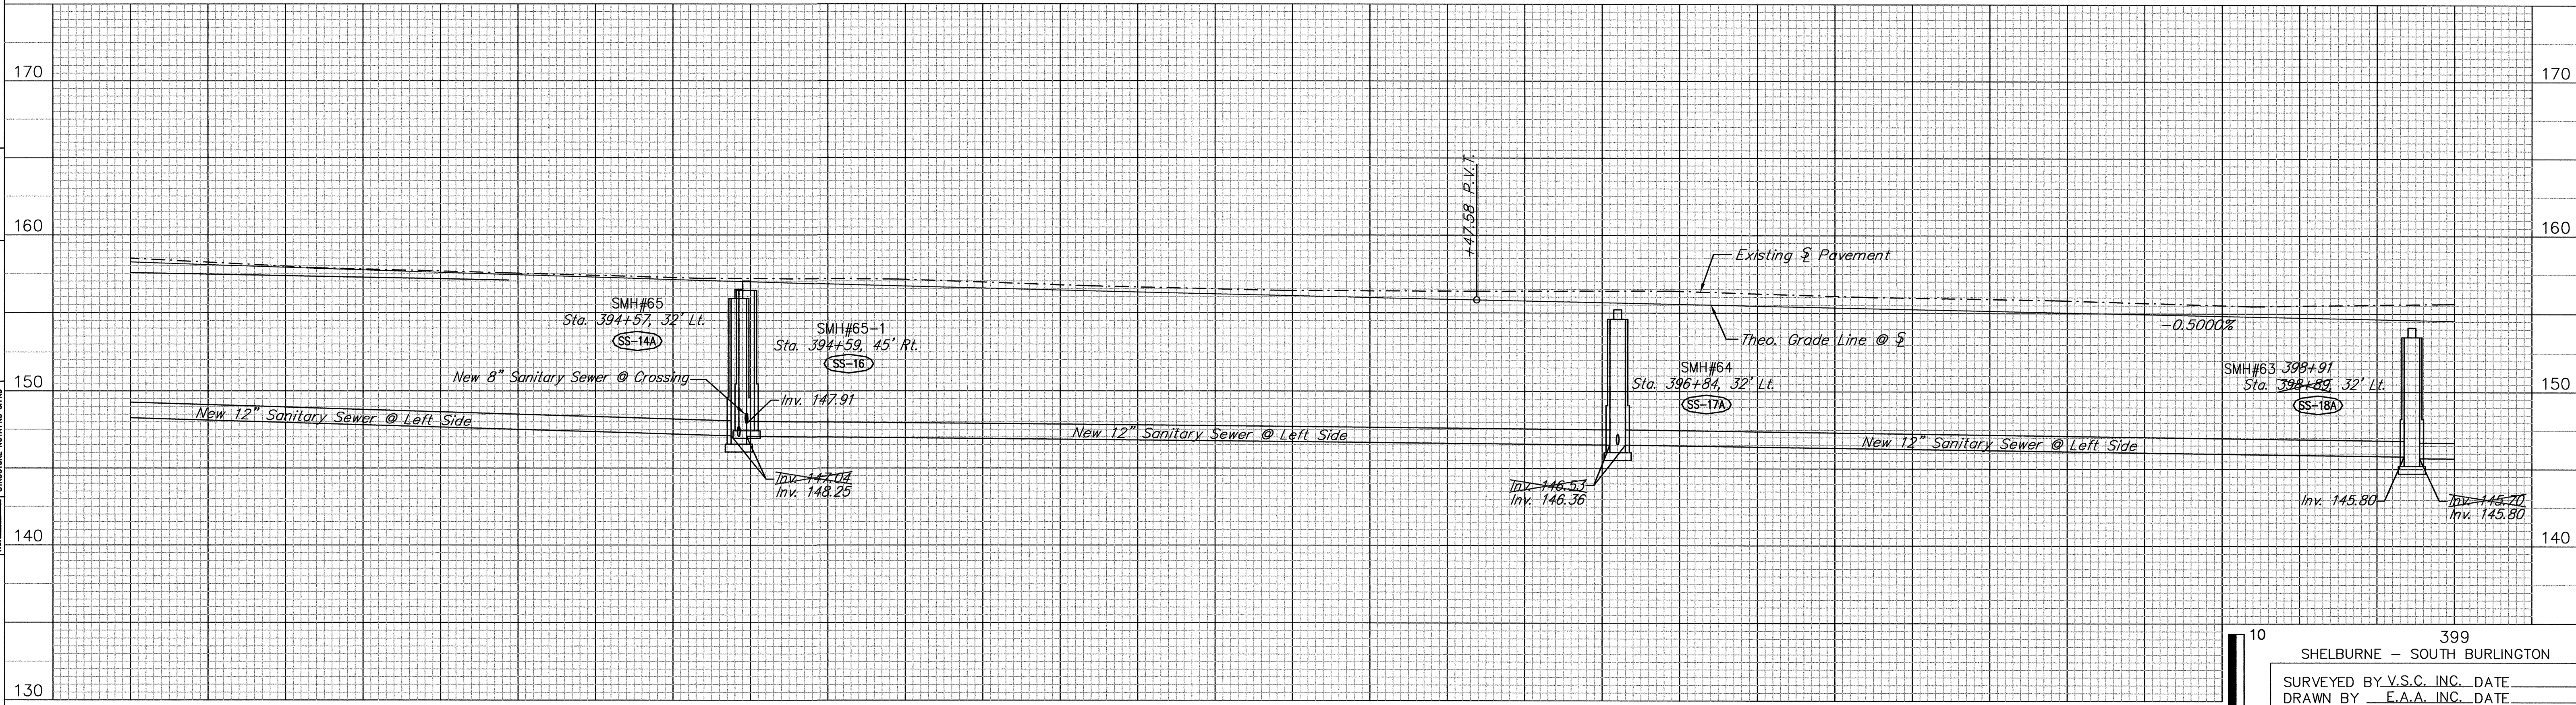

DATUM
 VERTICAL NGVD 1929
 HORIZONTAL NAD 1927

AS-BUILT REVISIONS		
NO.	DATE	DESCRIPTION
1.	3/2/06	SEWER EDITS

FOR PLAN SEE PLAN DRAWING NO. 5

REVISSED SEWER DESIGN
 SCALE IN FEET
 0 20 40

399
 SHELburnE - SOUTH BURLINGTON
 SURVEYED BY V.S.C. INC. DATE _____
 DRAWN BY E.A.A. INC. DATE _____
 TRACED BY E.A.A. INC. DATE _____
 PROJECT NH-EGC-019-4(28)
 PROFILE DRAWING NO. 5
 SHEET NO. 84R OF 283