


PLAN	DATE
SAVED	
ADJUSTMENT CHECKED	
RT. OF WAY CHECKED	
NOTE BOOK NO.	
BY	


PROFILE	DATE
SAVED	
GRADES CHECKED	
STRUCTURE NOTATIONS OK'D	
NOTE BOOK NO.	
BY	

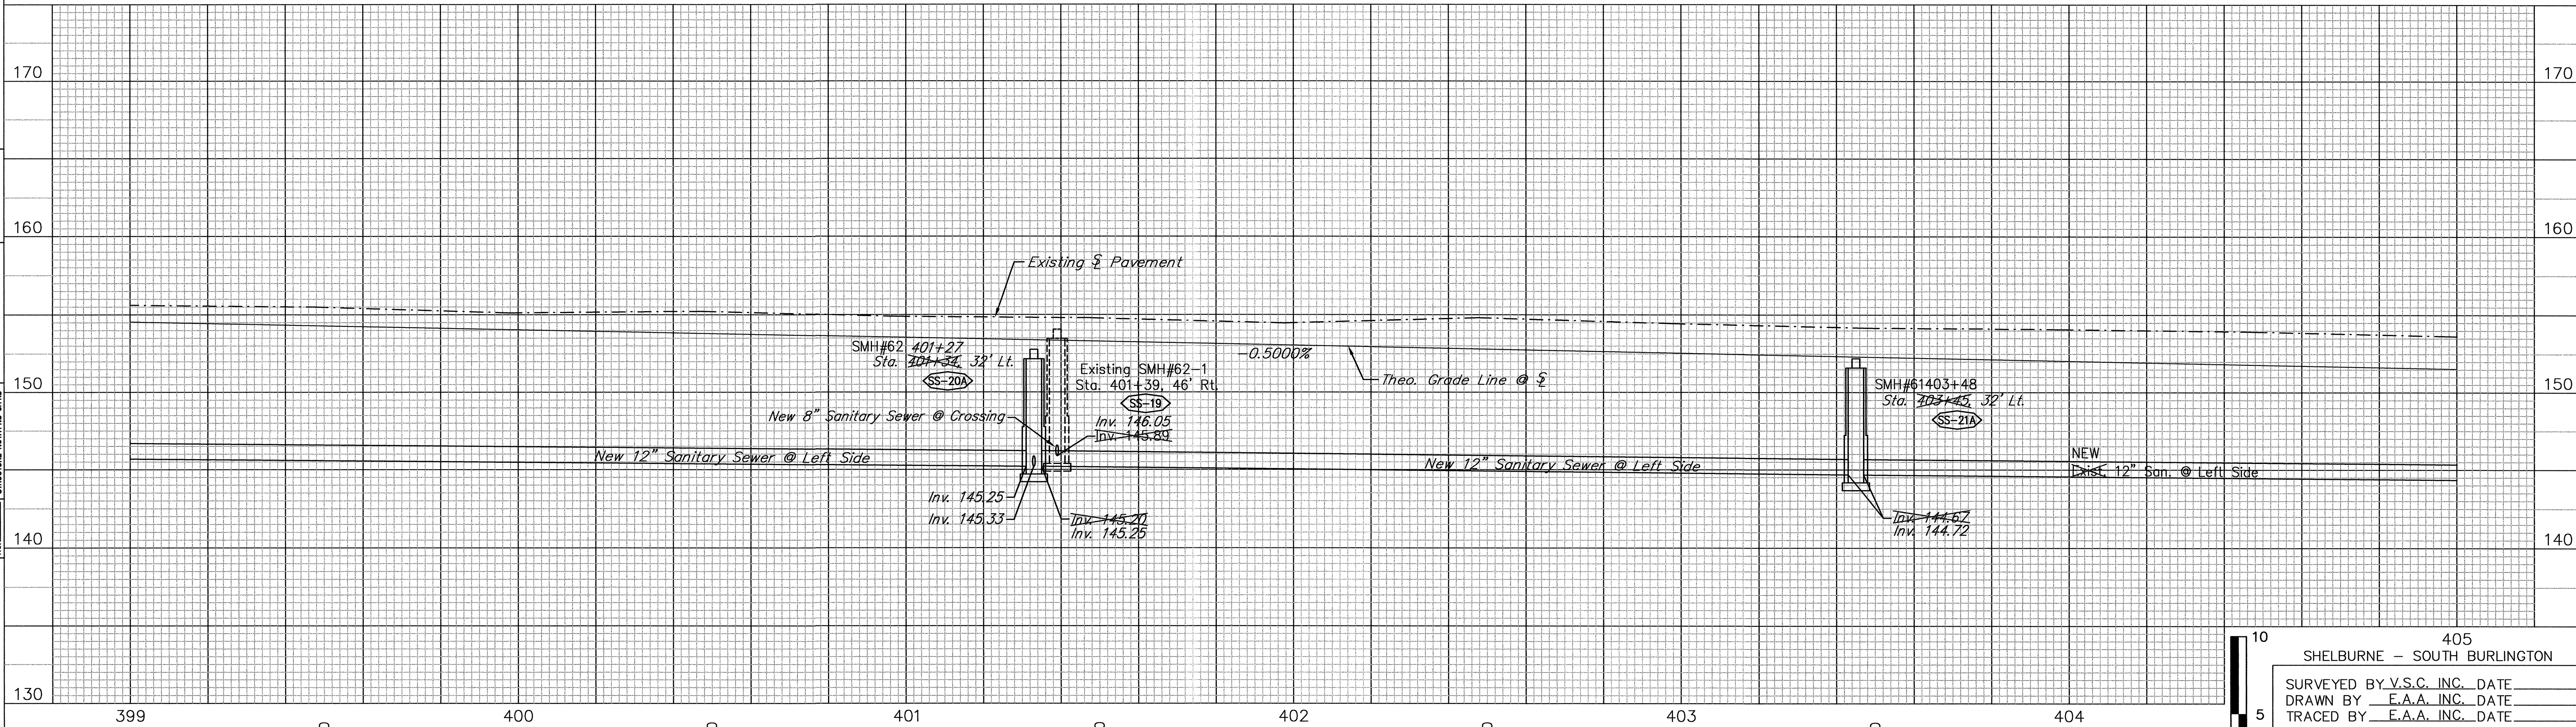

DATUM
 VERTICAL NGVD 1929
 HORIZONTAL NAD 1927

AS-BUILT REVISIONS		
NO.	DATE	DESCRIPTION
1.	3/2/06	SEWER EDITS

FOR PLAN SEE PLAN DRAWING NO. 6

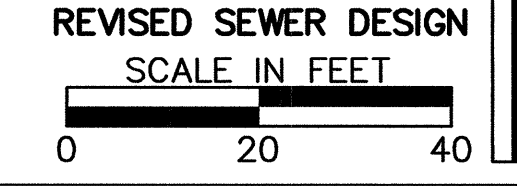

405
 SHELburne - SOUTH BURLINGTON

SURVEYED BY V.S.C. INC. DATE _____
 DRAWN BY E.A.A. INC. DATE _____
 TRACED BY E.A.A. INC. DATE _____

PROJECT NH-EGC-019-4(28)
 PROFILE DRAWING NO. 6
 SHEET NO. 85R OF 283