


DATE  
BY  
PLAN  
SHEET NO.  
DATE  
BY  
PLAN  
SHEET NO.


DATE  
BY  
PROFILE  
SHEET NO.  
DATE  
BY  
PROFILE  
SHEET NO.

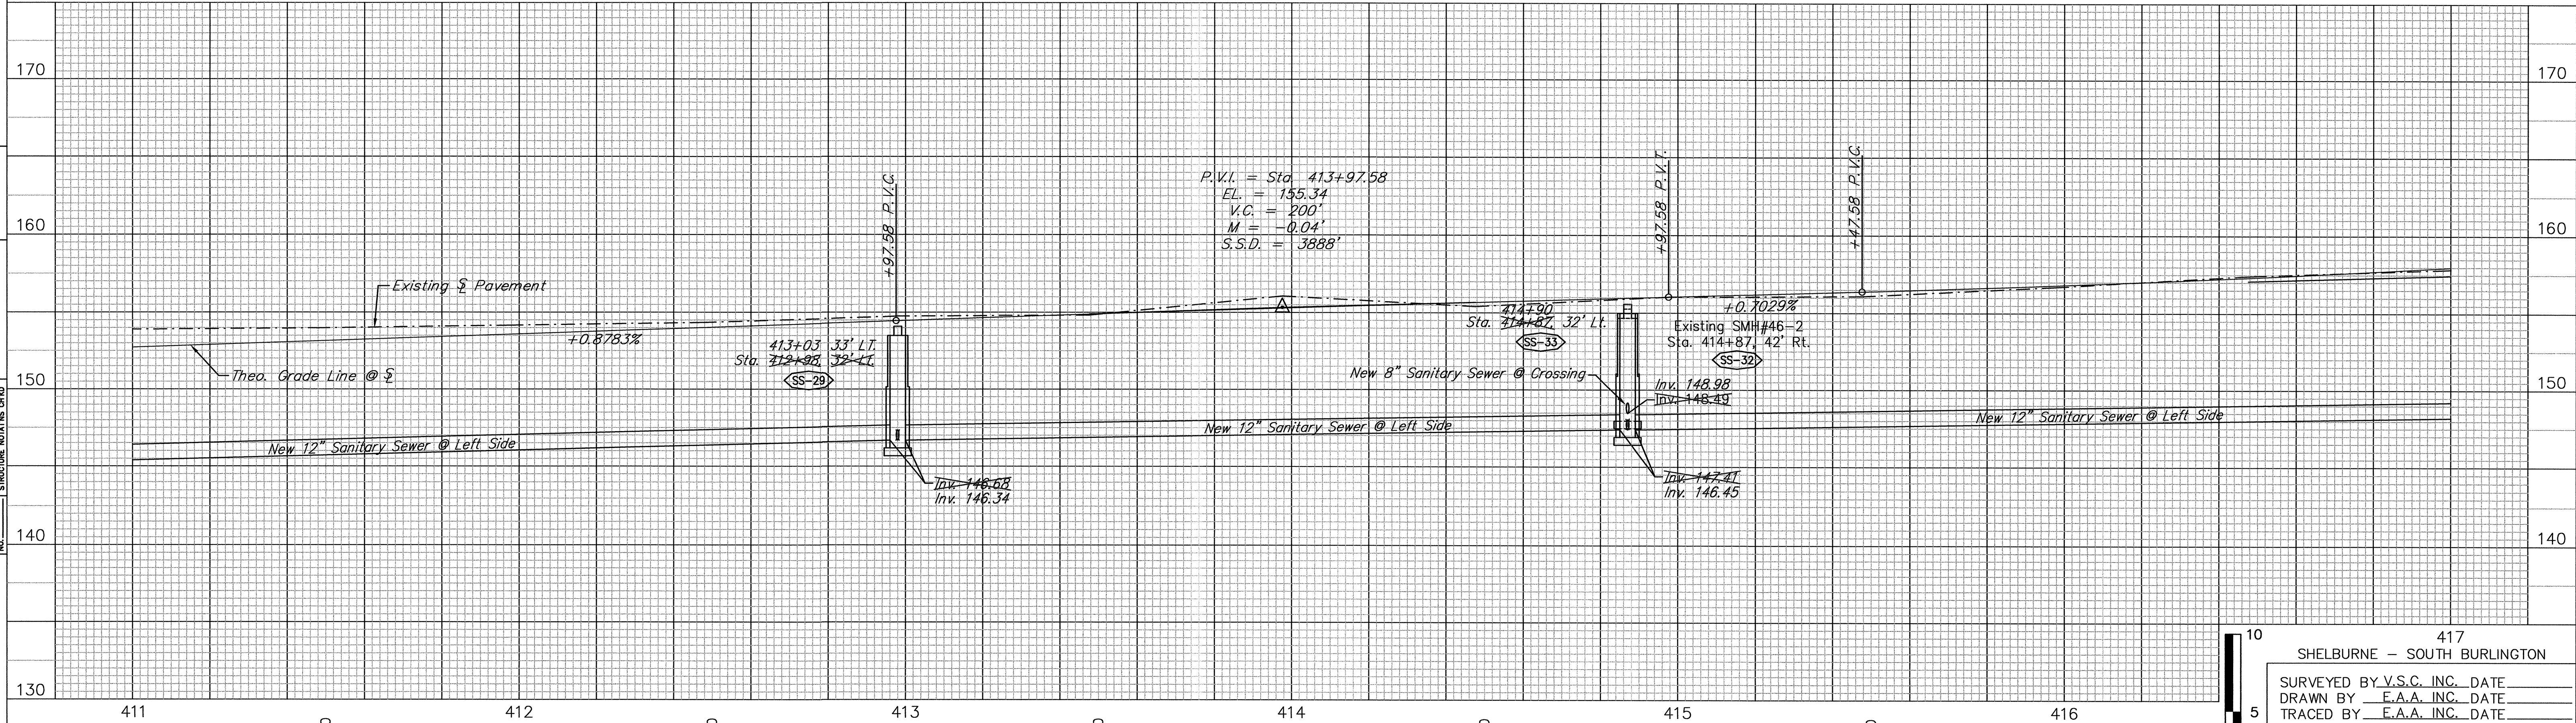

AS-BUILT REVISIONS		
NO.	DATE	DESCRIPTION
1.	3/2/06	SEWER EDITS

DATUM  
VERTICAL NGVD 1929  
HORIZONTAL NAD 1927

FOR PLAN SEE PLAN DRAWING NO. 8

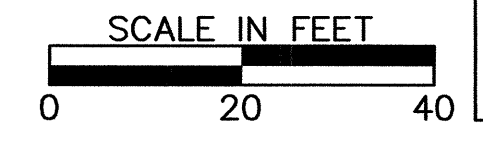

417  
SHELburne - SOUTH BURLINGTON

SURVEYED BY V.S.C. INC. DATE \_\_\_\_\_  
 DRAWN BY E.A.A. INC. DATE \_\_\_\_\_  
 TRACED BY E.A.A. INC. DATE \_\_\_\_\_

PROJECT NH-EGC-019-4(28)  
 PROFILE DRAWING NO. 8  
 SHEET NO. 87 OF 283