

REMOVING SIGNS
10 EA


- NOTES:
1. ALL SIGNS TO BE REMOVED UNLESS OTHERWISE NOTED.
 2. SIGN INVENTORY AS OF NOVEMBER 2002

DATUM
VERTICAL NGVD 1929
HORIZONTAL NAD 1927

AS-BUILT LEGEND
PAVEMENT OTHER
AS-BUILTS

AS-BUILT REVISIONS

NO.	DATE	DESCRIPTION
1.	8/05/06	NOTES ADDED PER ENGINEERS MARK UPS

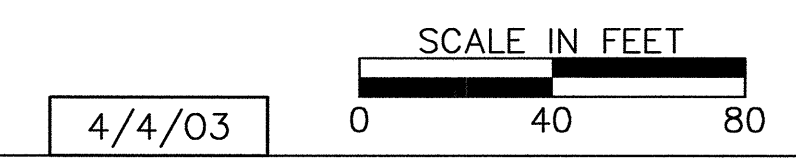

SHELBURNE - SOUTH BURLINGTON

SURVEYED BY V.S.C. INC. DATE _____
 DRAWN BY E.A.A. INC. DATE _____
 TRACED BY E.A.A. INC. DATE _____

PROJECT NH-EGC-019-4(28)
 SIGN REMOVAL DWG. NO. 1
 SHEET NO. 90 OF 283