

FROM	TO	ITEM 678.20 (MOD.) INTERCONNECT CONDUIT	ITEM 678.21 ELECTRICAL CONDUIT	ITEM 678.23 WIRED CONDUIT	ITEM 678.30 ELECTRICAL CONDUIT SLEEVE	DESCRIPTION		
				2"	2 1/2"	8"	12"	
CANTILEVER #2	PB S-9			27				SIGNAL
LOOP #1	PB S-9			2				LOOP #1
PB S-9	PB S-10			110				LOOP #1
PB S-9	CONTROLLER	110						INTERCONNECT
PB S-9	PB S-10			110				SIGNAL
PB S-9	PB S-10					85		SPARE
JB L-30	JB L-32			127				SOUTH BURLINGTON LIGHTING
CANTILEVER #1	PB S-10A			93				LOOP #4 / PRE-EMPTION
CANTILEVER #1	PB S-10A			93		37		SIGNAL
CANTILEVER #1	LOOP #4			20				LOOP #4
CANTILEVER #3	PB S-10			38				VAOT LIGHTING
CANTILEVER #3	PB S-10A			38				SIGNAL
PED POLE	PB S-10A			17				SIGNAL
LOOP #5	PB S-10A			3				LOOP #5
JB L-31	JB L-32			117				SOUTH BURLINGTON LIGHTING
PB S-10A	PB S-10			87				LOOP #4, #5 / PRE-EMPTION
PB S-10A	PB S-10			87				VAOT LIGHTING
PB S-10A	PB S-10			87				SIGNAL
PB S-10A	PB S-10	87				82		SPARE
CANTILEVER #4	PB S-10			13				PRE-EMPTION
CANTILEVER #4	PB S-10			13				VAOT LIGHTING
CANTILEVER #4	PB S-10			13				SIGNAL
PB S-10	CONTROLLER			23				LOOP #1, #4 & #5 / PRE-EMPTION
PB S-10	CONTROLLER			23				SIGNAL
PB S-10	LIGHT POLE V1			50				VAOT LIGHTING
LOOP #8A & 8B	CONTROLLER			33				LOOP #8A & #8B
STANCHION	PB S-10			21				VAOT LIGHTING
STANCHION	JB L-32			8				SOUTH BURLINGTON LIGHTING
STANCHION	CONTROLLER			25				SIGNAL
POWER SOURCE	STANCHION			40				SOUTH BURLINGTON LIGHTING
POWER SOURCE	STANCHION			40				SIGNAL / VAOT LIGHTING
CONTROLLER	JB 1-30	74						INTERCONNECT
TOTAL		184	197	1278	80		204	

LIGHTING ITEMS

ITEM 678.26 - JUNCTION BOX

383+13, 37' RT (L-30)
384+28, 48' LT (L-31)
384+35, 45' RT (L-32)

SIGNAL ITEMS



ITEM 678.27 - PULLBOX - DOUBLE

383+16, 34' RT (S-9)
384+12, 48' LT (S-10A)

ITEM 678.27 (MOD.) - PULLBOX - DOUBLE



384+27, 38' RT (S-10)

SLEEVE LOCATIONS	
383+24, 34.2' RT.	384+09, 37.0' RT.
384+12, 44.2' LT.	384+21, 34.7' RT.

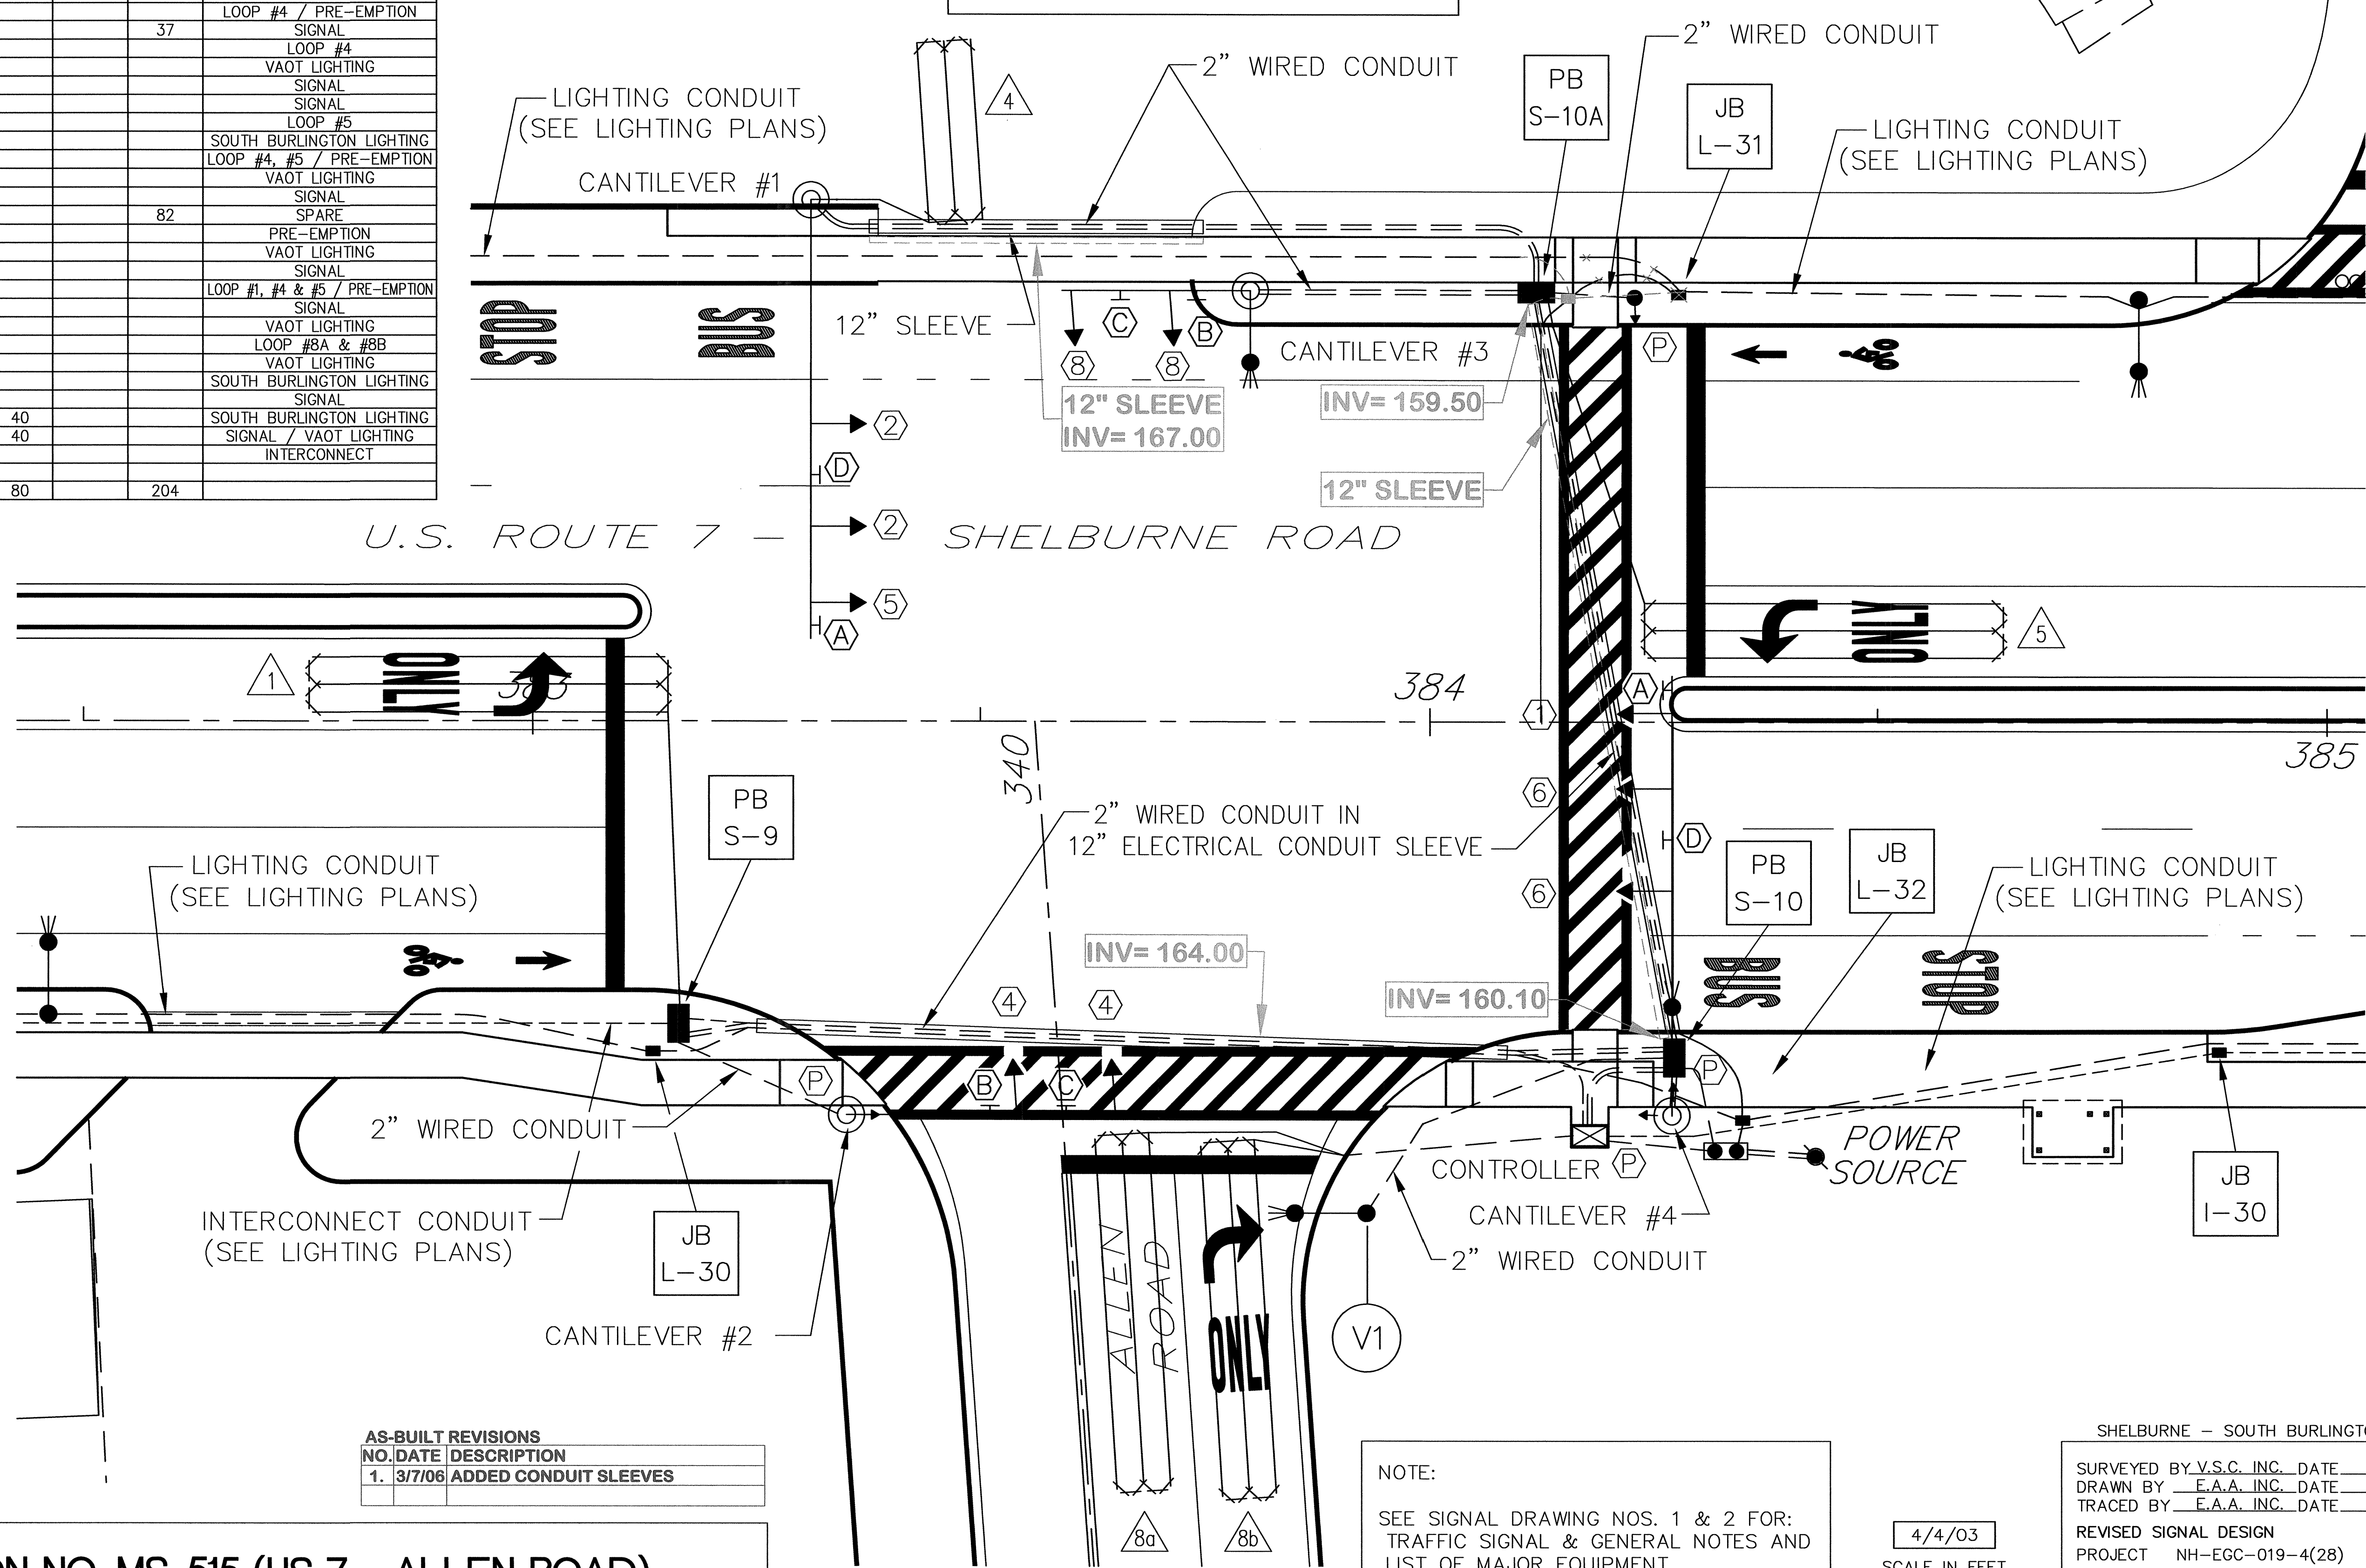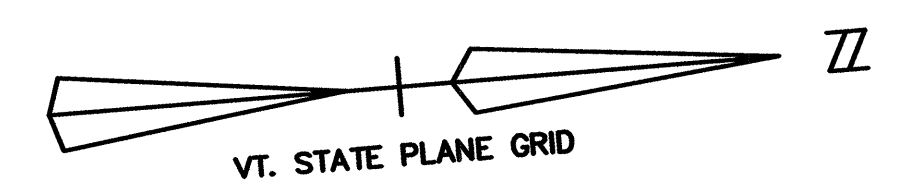

LEGEND


- ○ NEW SIGNAL FACE
- NEW STRAIN POLE W/ SPAN WIRE OR MAST ARM
- NEW PULLBOX
- NEW JUNCTION BOX
- NEW POWER STANCHION
- - - NEW SIGNAL CONDUIT
- - - NEW INTERCONNECT CONDUIT
- □ - NEW POWER POLE

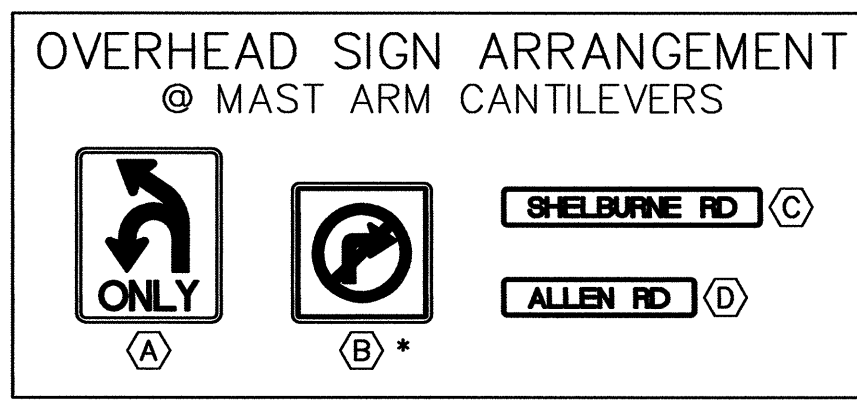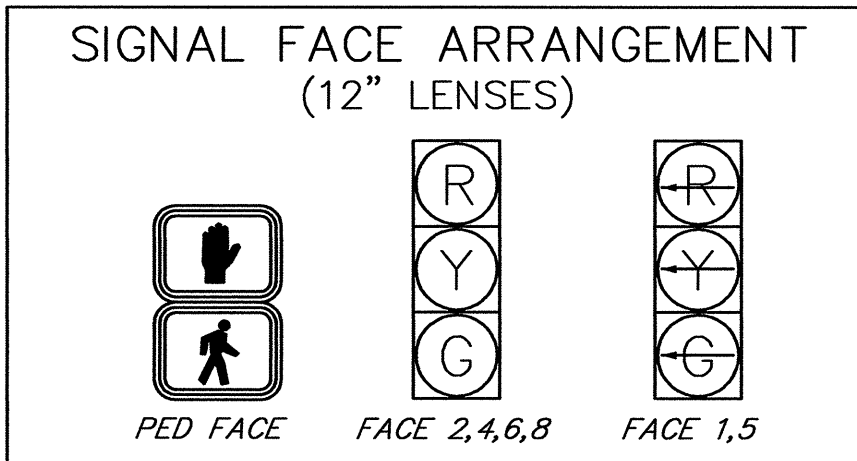

AS-BUILT REVISIONS

NO.	DATE	DESCRIPTION
1.	3/7/06	ADDED CONDUIT SLEEVES

NOTE:
SEE SIGNAL DRAWING NOS. 1 & 2 FOR:
TRAFFIC SIGNAL & GENERAL NOTES AND
LIST OF MAJOR EQUIPMENT.

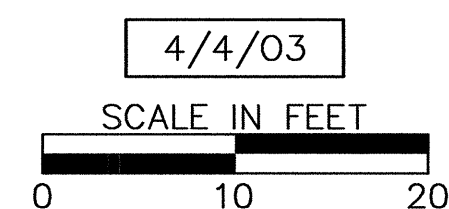

SHELburne - SOUTH BURLINGTON

SURVEYED BY: V.S.C. INC. DATE: _____
DRAWN BY: E.A.A. INC. DATE: _____
TRACED BY: E.A.A. INC. DATE: _____

REVISED SIGNAL DESIGN
PROJECT NH-EGC-019-4(28)
SIGNAL DRAWING NO. 3
SHEET NO. 128A OF 283

DATUM
VERTICAL NGVD 1929
HORIZONTAL NAD 1927

INTERSECTION NO. MS-515 (US 7 - ALLEN ROAD)