


MATCH TO PLAN DRAWING NO. L4, STA. 381+00

AS-BUILT REVISIONS		
NO.	DATE	DESCRIPTION
1.	6/30/06	TREE TYPES ADDED TO PLANS


AS-BUILT LEGEND	
	WATER AS-BUILTS
	SEWER AS-BUILTS
	DRAINAGE AS-BUILTS
	ELECTRICAL AS-BUILTS
	PAVEMENT / OTHER AS-BUILTS

**LEGEND**

	EXISTING TREELINE		PROPOSED DECIDUOUS TREE WITH PLANT TYPE AND PAY ITEM
	EXISTING DECIDUOUS TREE		EXISTING TREE TO BE SAVED
	TOE OF SLOPE		UTILITY POLE
	TOP OF CUT		STREET LIGHT

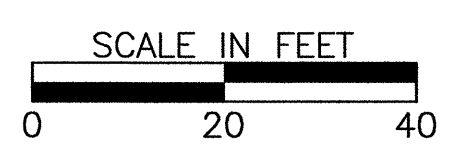

DATUM	
VERTICAL	_____
HORIZONTAL	_____

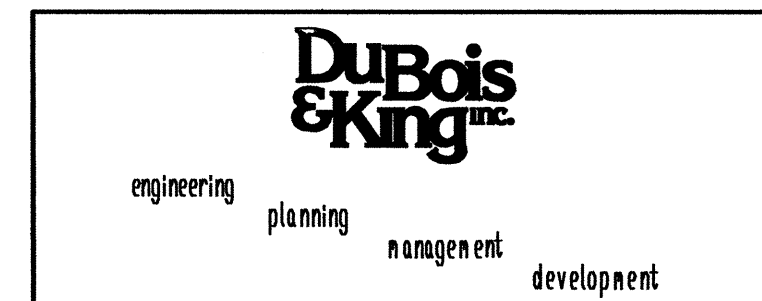

**LANDSCAPE PLAN**  
STA 375+00 TO 381+00

PROJECT: U.S. ROUTE 7  
DESIGN FILE NAME:  
IPARM FILE NAME:  
SURVEYED BY: V.S.C. INC.  
SQUAD LEADER: JOHN STEELE

SHEET NO. 164 OF 283  
PROJECT NO.: NH-EGC-019-4(28)  
PLOT DATE: 4/4/03  
SURVEY DATE:  
DRAWN BY: K. KOLOSKI  
SHEET: L3 OF L14