

AS-BUILT REVISIONS


NO.	DATE	DESCRIPTION
1.	6/30/06	TREE TYPES ADDED TO PLANS

AS-BUILT LEGEND

	WATER AS-BUILTS
	SEWER AS-BUILTS
	DRAINAGE AS-BUILTS
	ELECTRICAL AS-BUILTS
	PAVEMENT OTHER AS-BUILTS


LEGEND

	EXISTING TREELINE
	EXISTING DECIDUOUS TREE
	TOE OF SLOPE
	TOP OF CUT
	PROPOSED DECIDUOUS TREE WITH PLANT TYPE AND PAY ITEM
	EXISTING TREE TO BE SAVED
	UTILITY POLE
	STREET LIGHT

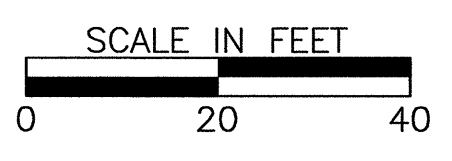

DATUM

VERTICAL	_____
HORIZONTAL	_____

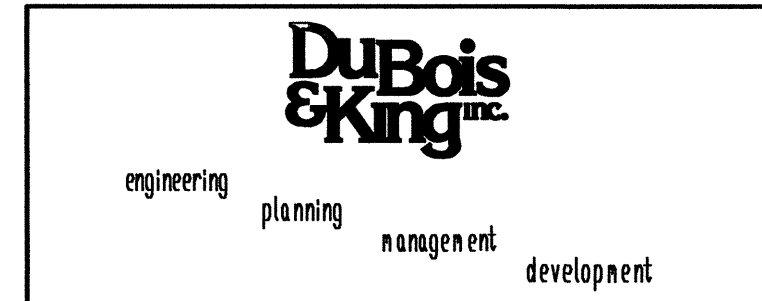

LANDSCAPE PLAN
STA 381+00 TO 387+00

PROJECT: U.S. ROUTE 7
DESIGN FILE NAME:
IPARM FILE NAME:
SURVEYED BY: V.S.C. INC.
SQUAD LEADER: JOHN STEELE

SHEET NO. 165 OF 283
PROJECT NO. : NH-EGC-019-4(28)
PLOT DATE: 4/4/03
SURVEY DATE:
DRAWN BY: K. KOLOSKI
SHEET: L4 OF L14