

MATCH TO PLAN DRAWING NO. L5, STA. 393+00

MATCH TO PLAN DRAWING NO. L7, STA. 399+00

LEGEND

- EXISTING TREELINE
- EXISTING DECIDUOUS TREE
- TOE OF SLOPE
- TOP OF CUT
- AP.01 PROPOSED DECIDUOUS TREE WITH PLANT TYPE AND PAY ITEM
- EXISTING TREE TO BE SAVED
- UTILITY POLE
- STREET LIGHT

AS-BUILT REVISIONS


NO.	DATE	DESCRIPTION
1.	7/5/06	TREE TYPES ADDED TO PLANS

AS-BUILT LEGEND

	WATER AS-BUILTS
	SEWER AS-BUILTS
	DRAINAGE AS-BUILTS
	ELECTRICAL AS-BUILTS
	PAVEMENT OTHER AS-BUILTS

DATUM

VERTICAL	_____
HORIZONTAL	_____

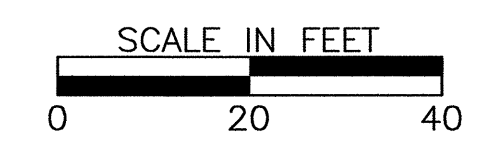

<p>engineering planning management development</p>	<p>LANDSCAPE PLAN</p> <p>STA 393+00 TO 399+00</p>	<p>PROJECT: U.S. ROUTE 7</p> <p>DESIGN FILE NAME: _____</p> <p>IPARM FILE NAME: _____</p> <p>SURVEYED BY: V.S.C. INC.</p> <p>SQUAD LEADER: JOHN STEELE</p>	<p>SHEET NO. 167 OF 283</p> <p>PROJECT NO.: NH-EGC-019-4(28)</p> <p>PLOT DATE: 4/4/03</p> <p>SURVEY DATE: _____</p> <p>DRAWN BY: K. KOLOSKI</p> <p>SHEET: L6 OF L14</p>
---	--	--	---