


MATCH TO PLAN DRAWING NO. L7, STA. 405+00

MATCH TO PLAN DRAWING NO. L9, STA. 411+00

**LEGEND**


- EXISTING TREELINE
- EXISTING DECIDUOUS TREE
- PROPOSED DECIDUOUS TREE WITH PLANT TYPE AND PAY ITEM
- EXISTING TREE TO BE SAVED
- UTILITY POLE
- STREET LIGHT
- TOE OF SLOPE
- TOP OF CUT

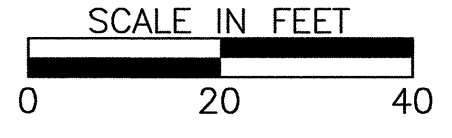

AS-BUILT REVISIONS	
NO.	DATE
1.	7/5/06

AS-BUILT LEGEND	
	WATER AS-BUILTS
	SEWER AS-BUILTS
	DRAINAGE AS-BUILTS
	ELECTRICAL AS-BUILTS
	PAVEMENT / OTHER AS-BUILTS

DATUM	
VERTICAL	_____
HORIZONTAL	_____

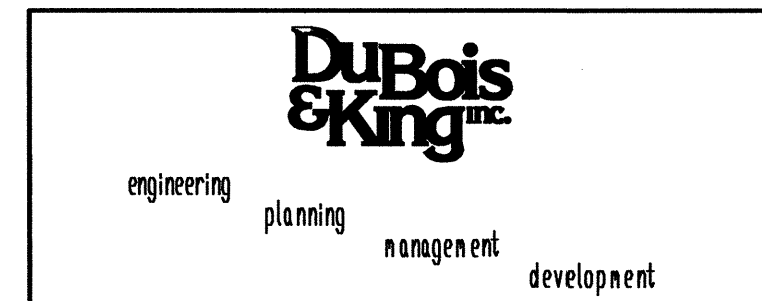

**LANDSCAPE PLAN**  
STA 405+00 TO 411+00

PROJECT: U.S. ROUTE 7  
DESIGN FILE NAME:  
IPARM FILE NAME:  
SURVEYED BY: V.S.C. INC.  
SQUAD LEADER: JOHN STEELE

PROJECT NO. : NH-EGC-019-4(28)  
PLOT DATE: 4/4/03  
SURVEY DATE:  
DRAWN BY: K. KOLOSKI  
SHEET: L8 OF L14

SHEET NO. 169 OF 283