

MATCH TO PLAN DRAWING NO. LB. STA. 411+00


MATCH TO PLAN DRAWING NO. L10. STA. 417+00

AS-BUILT REVISIONS	
NO.	DATE
1.	7/5/06
TREE TYPES ADDED TO PLANS	


AS-BUILT LEGEND	
	WATER AS-BUILTS
	SEWER AS-BUILTS
	DRAINAGE AS-BUILTS
	ELECTRICAL AS-BUILTS
	PAVEMENT (OTHER AS-BUILTS)

LEGEND

- EXISTING TREELINE
- EXISTING DECIDUOUS TREE
- TOE OF SLOPE
- TOP OF CUT
- PROPOSED DECIDUOUS TREE WITH PLANT TYPE AND PAY ITEM
- EXISTING TREE TO BE SAVED
- UTILITY POLE
- STREET LIGHT

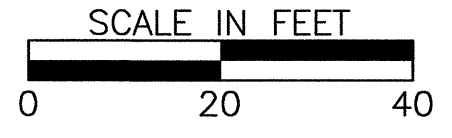

DATUM	
VERTICAL	_____
HORIZONTAL	_____

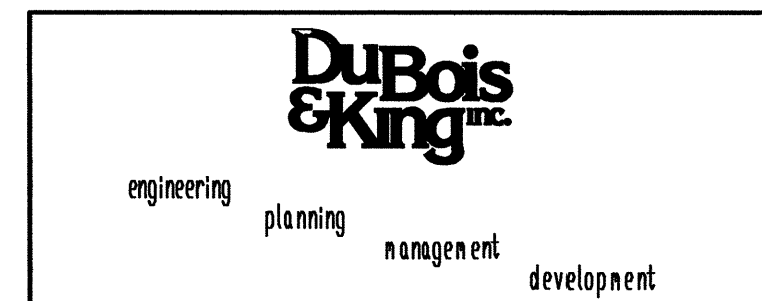

**LANDSCAPE PLAN**  
STA 411+00 TO 417+00

PROJECT: U.S. ROUTE 7  
 DESIGN FILE NAME:  
 IPARM FILE NAME:  
 SURVEYED BY: V.S.C. INC.  
 SQUAD LEADER: JOHN STEELE

SHEET NO. 170 OF 283  
 PROJECT NO.: NH-EGC-019-4(28)  
 PLOT DATE: 4/4/03  
 SURVEY DATE:  
 DRAWN BY: K. KOLOSKI  
 SHEET: L9 OF L14