


DATUM ELEV = 185.00

DATUM ELEV = 185.00

DATUM ELEV = 185.00

DATUM ELEV = 185.00

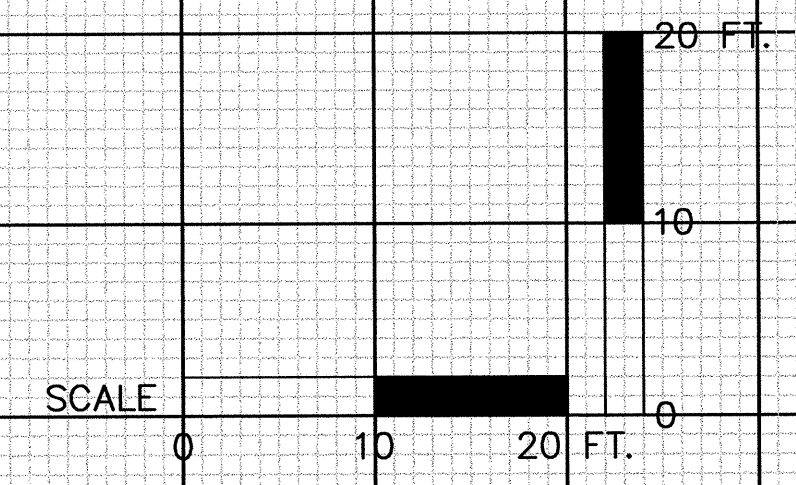

**ERDMAN ANTHONY**  
CONSULTING ENGINEERS  
Rochester, New York    Camp Hill, Pennsylvania  
Boston, Massachusetts

**AS-BUILT REVISIONS**

| NO. | DATE    | DESCRIPTION                         |
|-----|---------|-------------------------------------|
| 1.  | 8/29/06 | CHANGES MADE PER AS-BUILTS MARK UPS |

4/4/03

SHELburnE - SOUTH BURLINGTON  
STA. 373+48 TO STA. 374+48  
SURVEYED BY: V.S.C. INC.    DATE: \_\_\_\_\_  
DRAWN BY: E.A.A. INC.    DATE: \_\_\_\_\_  
TRACED BY: E.A.A. INC.    DATE: \_\_\_\_\_  
PROJECT: NH-EGC-019-4(28)  
CROSS-SECTION DWG. NO. 86  
SHEET 178 OF 283