

ERDMAN ANTHONY
 CONSULTING ENGINEERS
 Rochester, New York Camp Hill, Pennsylvania
 Boston, Massachusetts


130 120 110 100 90 80 70 60 50 40 30 20 10 0 10 20 30 40 50 60 70 80 90 100 110 120

AS-BUILT REVISIONS

NO.	DATE	DESCRIPTION
1.	8/29/06	CHANGES MADE PER AS-BUILTS MARK UPS

4/4/03

SHELburne - SOUTH BURLINGTON
 STA. 376+00 TO STA. 377+00
 SURVEYED BY V.S.C. INC. DATE _____
 DRAWN BY E.A.A. INC. DATE _____
 TRACED BY E.A.A. INC. DATE _____
 PROJECT NH-EGC-019-4(28)
 CROSS-SECTION DWG. NO. 88
 SHEET 180 OF 283

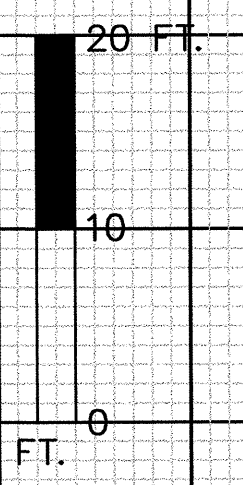

SCALE