

DATUM ELEV = 170.00

DATUM ELEV = 170.00

DATUM ELEV = 170.00

DATUM ELEV = 175.00


ERDMAN ANTHONY
CONSULTING ENGINEERS
Rochester, New York Camp Hill, Pennsylvania
Boston, Massachusetts

130 120 110 100 90 80 70 60 50 40 30 20 10 0 10 20 30 40 50 60 70 80 90 100 110 120

AS-BUILT REVISIONS

NO.	DATE	DESCRIPTION
1.	8/29/06	CHANGES MADE PER AS-BUILTS MARK UPS

4/4/03

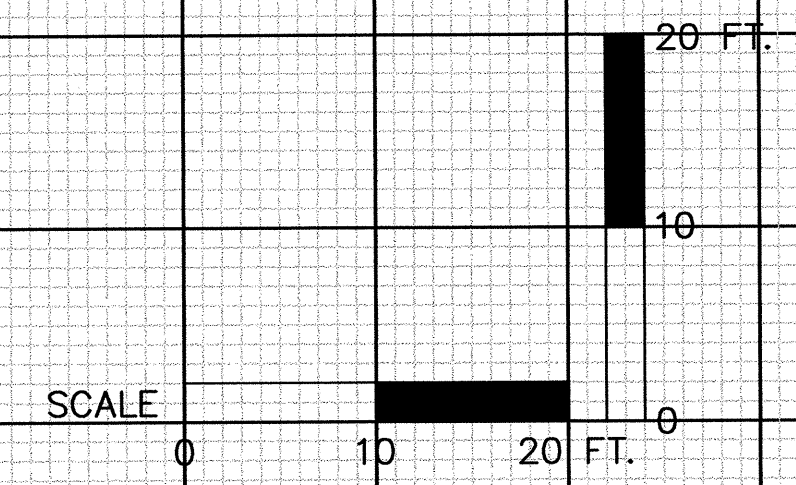

SHELburne - SOUTH BURLINGTON

STA. 378+98 TO STA. 380+48

SURVEYED BY: V.S.C. INC. DATE: _____
 DRAWN BY: E.A.A. INC. DATE: _____
 TRACED BY: E.A.A. INC. DATE: _____

PROJECT: NH-EGC-019-4(28)

CROSS-SECTION DWG. NO. 90

SHEET 182 OF 283