

DATUM ELEV = 155.00

DATUM ELEV = 155.00

DATUM ELEV = 155.00

DATUM ELEV = 155.00

EXISTING BLDG. #1800  
STA. 388+32 TO 389+51


EXISTING BLDG. #1800  
STA. 388+32 TO 389+51

EXISTING BLDG. #1795  
STA. 387+50 TO 388+16

- 1 = EXIST. GRADE AT 387+48
- 2 = EXIST. GRADE AT 1" PE GAS
- 3 = FINISHED GRADE AT 1" PE GAS

STA. 387+63, 44' LT.  
BUILD NEW 48" DIA. C.B.  
T.G. 163.91  
INV. 157.37 18" OPTION PIPE, S IN  
157.37 18" OPTION PIPE, N OUT

STA. 387+30, 30' RT.  
BUILD NEW 48" DIA. C.B.  
T.G. 164.42  
INV. 157.88 18" OPTION PIPE, S IN  
157.88 18" OPTION PIPE, N OUT

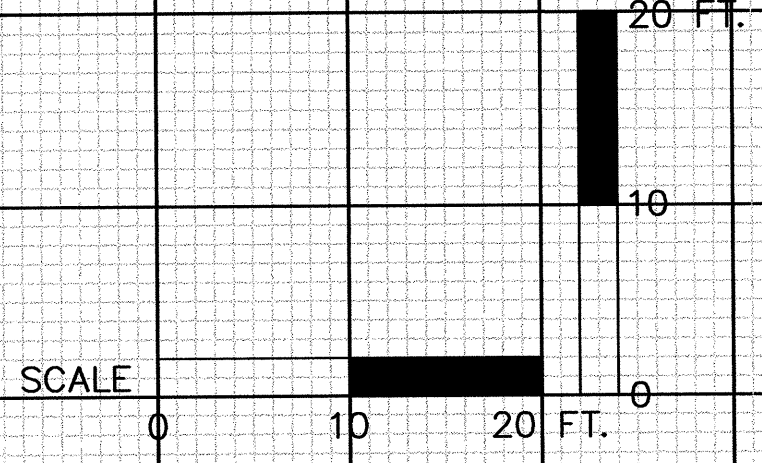

SHELburne - SOUTH BURLINGTON  
STA. 387+48 TO STA. 388+82

SURVEYED BY V.S.C. INC. DATE \_\_\_\_\_  
DRAWN BY E.A.A. INC. DATE \_\_\_\_\_  
TRACED BY E.A.A. INC. DATE \_\_\_\_\_  
PROJECT NH-EGC-019-4(28)  
CROSS-SECTION DWG. NO. 95  
SHEET 187 OF 283

**ERDMAN ANTHONY**  
CONSULTING ENGINEERS  
Rochester, New York Camp Hill, Pennsylvania  
Boston, Massachusetts

AS-BUILT REVISIONS	
NO.	DESCRIPTION
1.	8/29/06 CHANGES MADE PER AS-BUILTS MARK UPS

4/4/03