


DATUM ELEV = 155.00

DATUM ELEV = 155.00

DATUM ELEV = 155.00

DATUM ELEV = 155.00

CONSTRUCT HARBOR VIEW ROAD
STA. 390+29.66 = 370+00.00

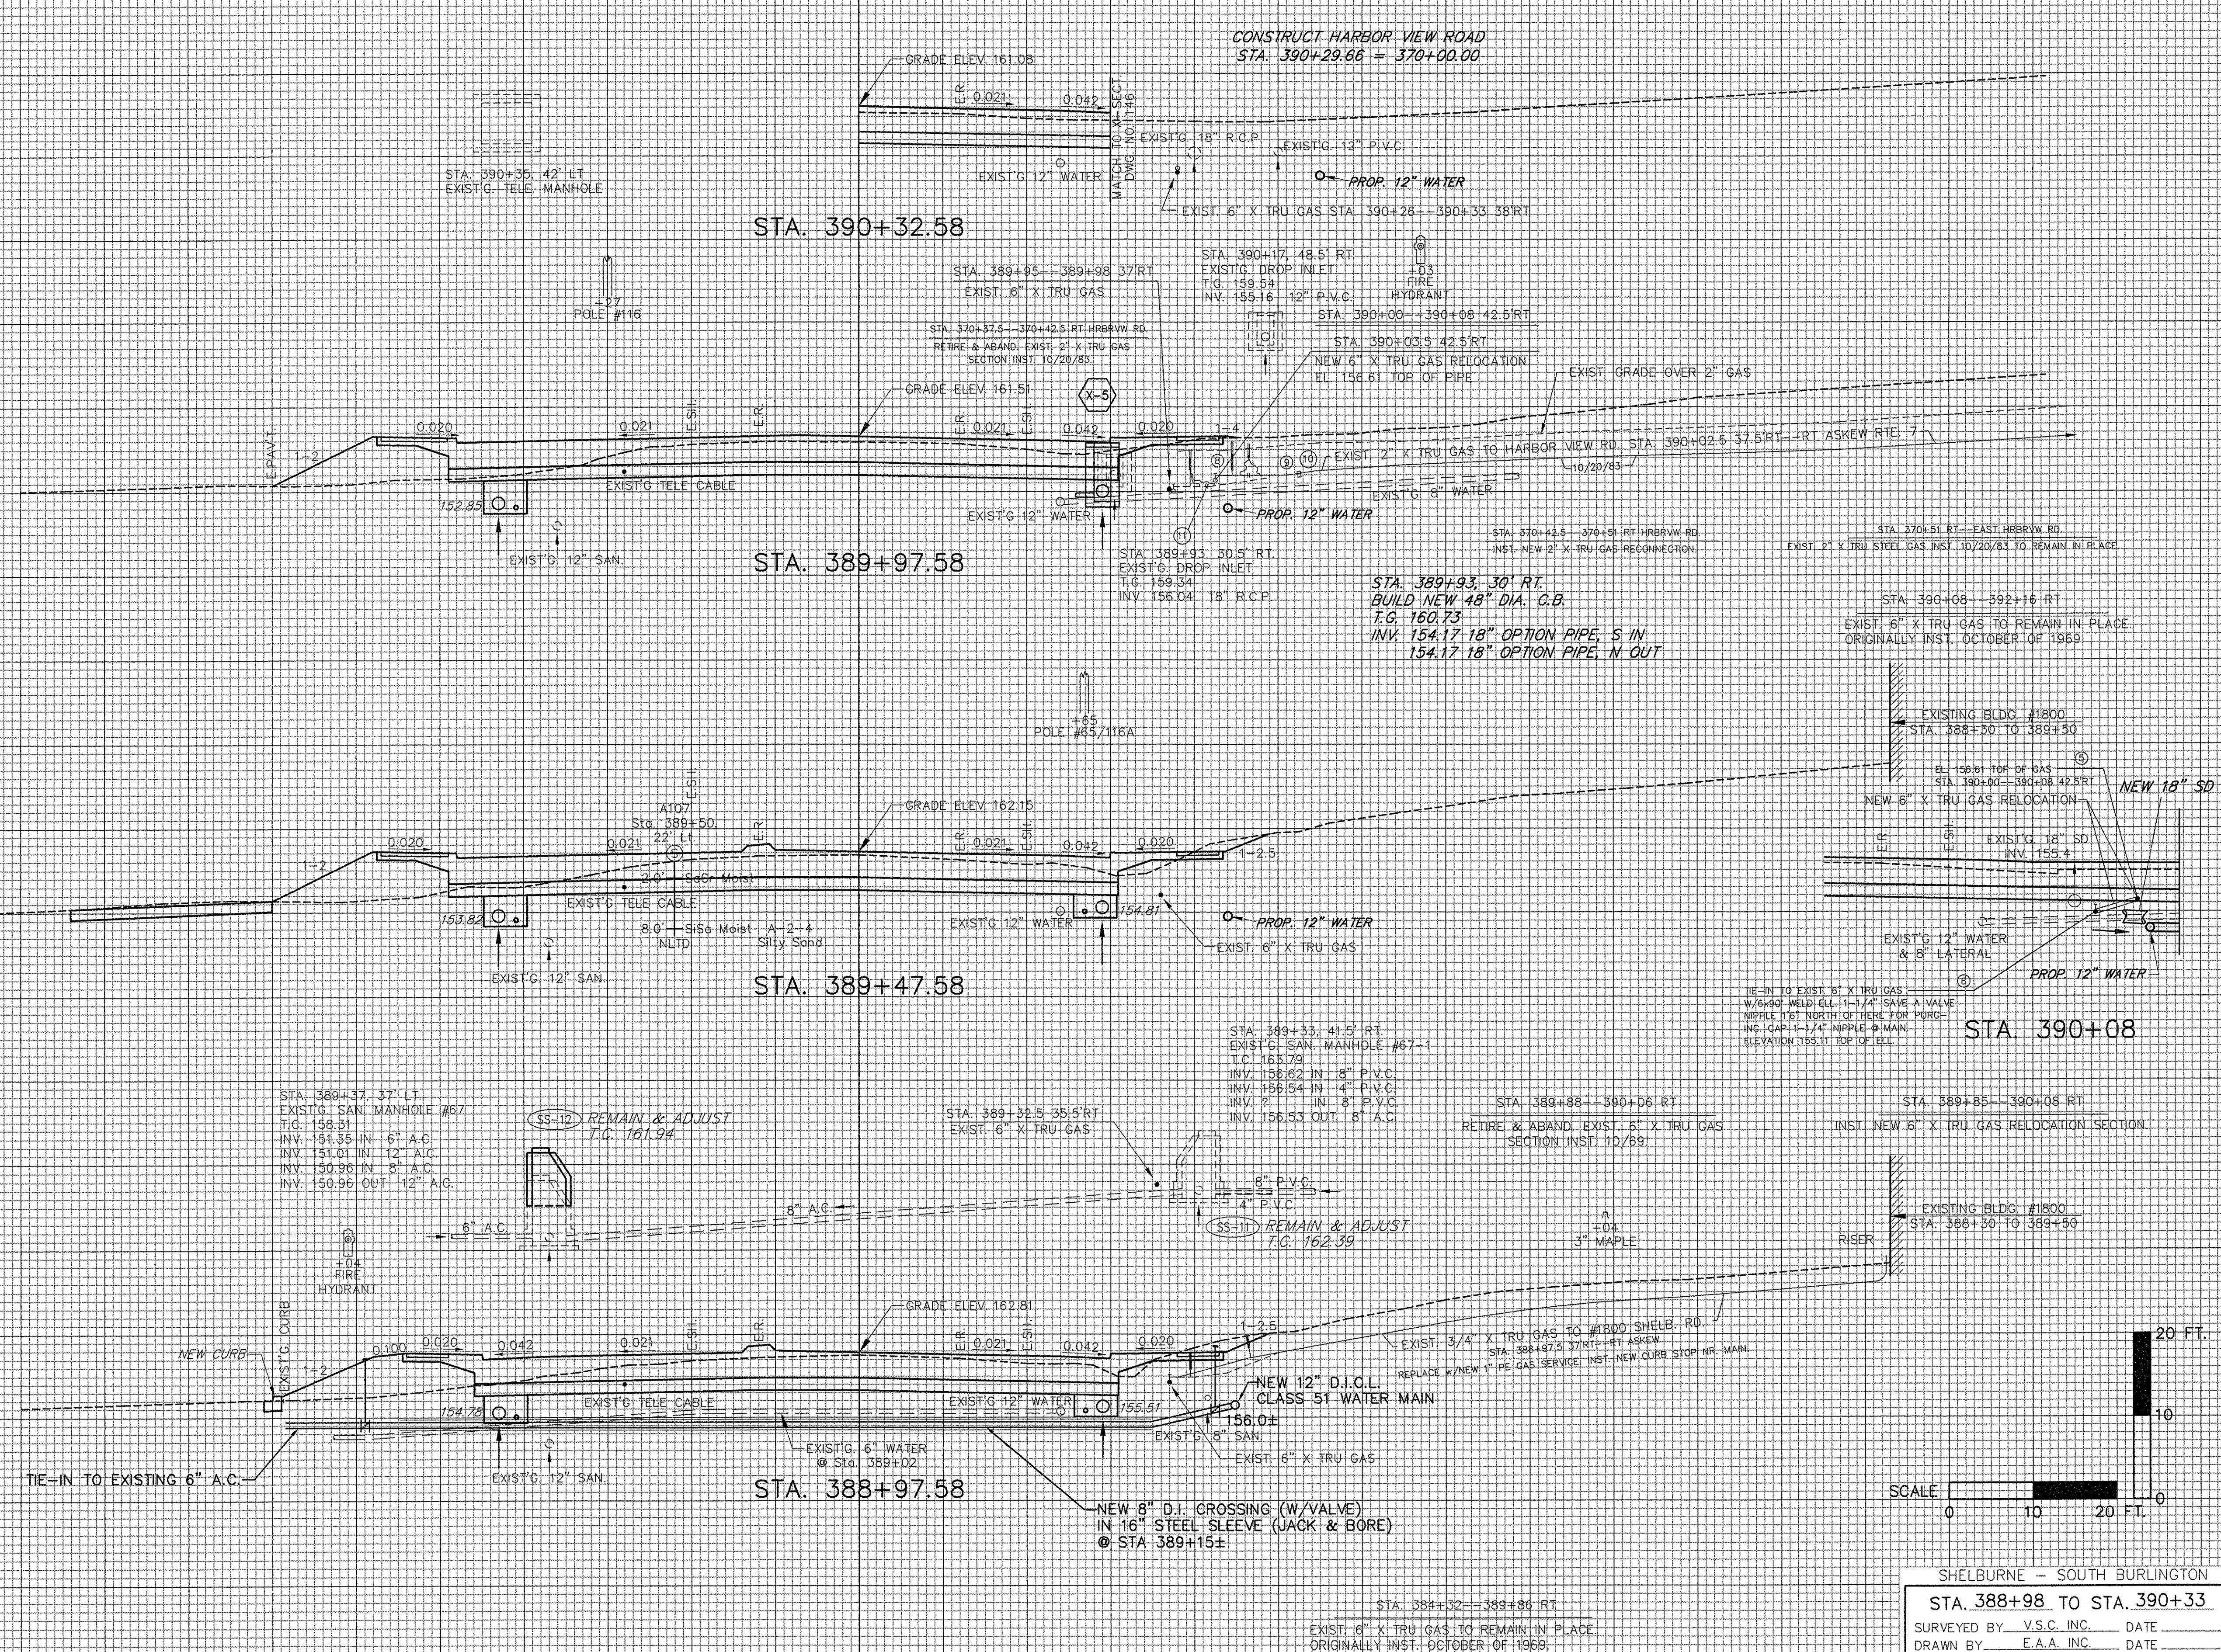

STA. 389+37.37 LT.
EXIST'G SAN MANHOLE #67
T.G. 158.31
INV. 151.35 IN 6" A.C.
INV. 151.01 IN 12" A.C.
INV. 150.96 IN 8" A.C.
INV. 150.96 OUT 12" A.C.

SS-12 REMAIN & ADJUST
T.C. 161.94

STA. 389+33.41 S RT.
EXIST'G SAN MANHOLE #67-1
T.C. 163.79
INV. 156.82 IN 8" P.V.C.
INV. 156.54 IN 4" P.V.C.
INV. 2 IN 8" P.V.C.
INV. 156.53 OUT 8" A.C.

STA. 389+88--390+06 RT.
RETIRED & ABAND. EXIST. 6" X TRU GAS
SECTION INST. 10/69

STA. 389+85--390+05 RT.
INST. NEW 6" X TRU GAS RELOCATION SECTION

SS-11 REMAIN & ADJUST
T.C. 162.39

SCALE 0 10 20 FT.

SHELBURNE - SOUTH BURLINGTON
STA. 388+98 TO STA. 390+33
SURVEYED BY V.S.C. INC. DATE _____
DRAWN BY E.A.A. INC. DATE _____
TRACED BY E.A.A. INC. DATE _____
PROJECT NH-EGC-019-4(28)
CROSS-SECTION DWG. NO. 96
SHEET 188 OF 283