

DATUM ELEV = 150.00

DATUM ELEV = 150.00

DATUM ELEV = 150.00


DATUM ELEV = 150.00

STA. 395+04.58

STA. 394+97.58

STA. 394+47.58

STA. 394+27.58

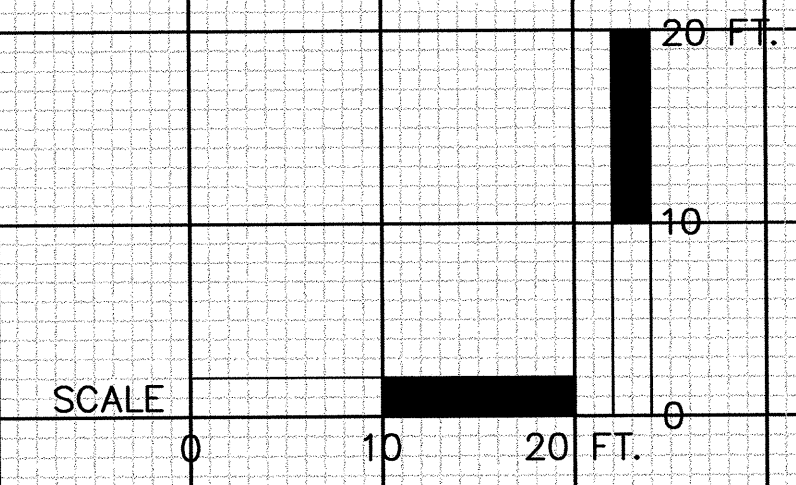

SHELburnE - SOUTH BURLINGTON

STA. 394+28 TO STA. 395+05

SURVEYED BY V.S.C. INC. DATE _____
 DRAWN BY E.A.A. INC. DATE _____
 TRACED BY E.A.A. INC. DATE _____

PROJECT NH-EGC-019-4(28)

CROSS-SECTION DWG. NO. 99

SHEET 191R OF 283

AS-BUILT REVISIONS		REVISED SEWER DESIGN
NO.	DATE	DESCRIPTION
1.	8/29/06	CHANGES MADE PER AS-BUILTS MARK UPS
	4/4/03	

ERDMAN ANTHONY
 CONSULTING ENGINEERS
 Rochester, New York Camp Hill, Pennsylvania
 Boston, Massachusetts

130 120 110 100 90 80 70 60 50 40 30 20 10 0 10 20 30 40 50 60 70 80 90 100 110 120