
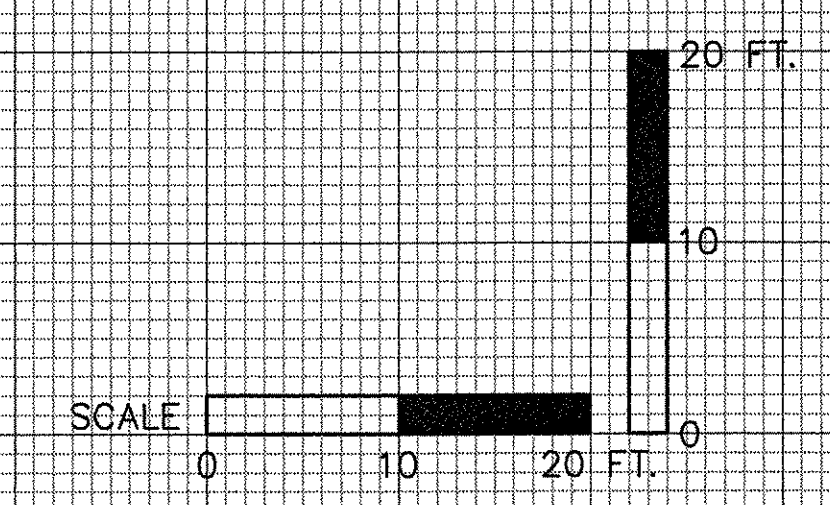


DATUM ELEV = 150.00

DATUM ELEV = 150.00

DATUM ELEV = 150.00

DATUM ELEV = 150.00

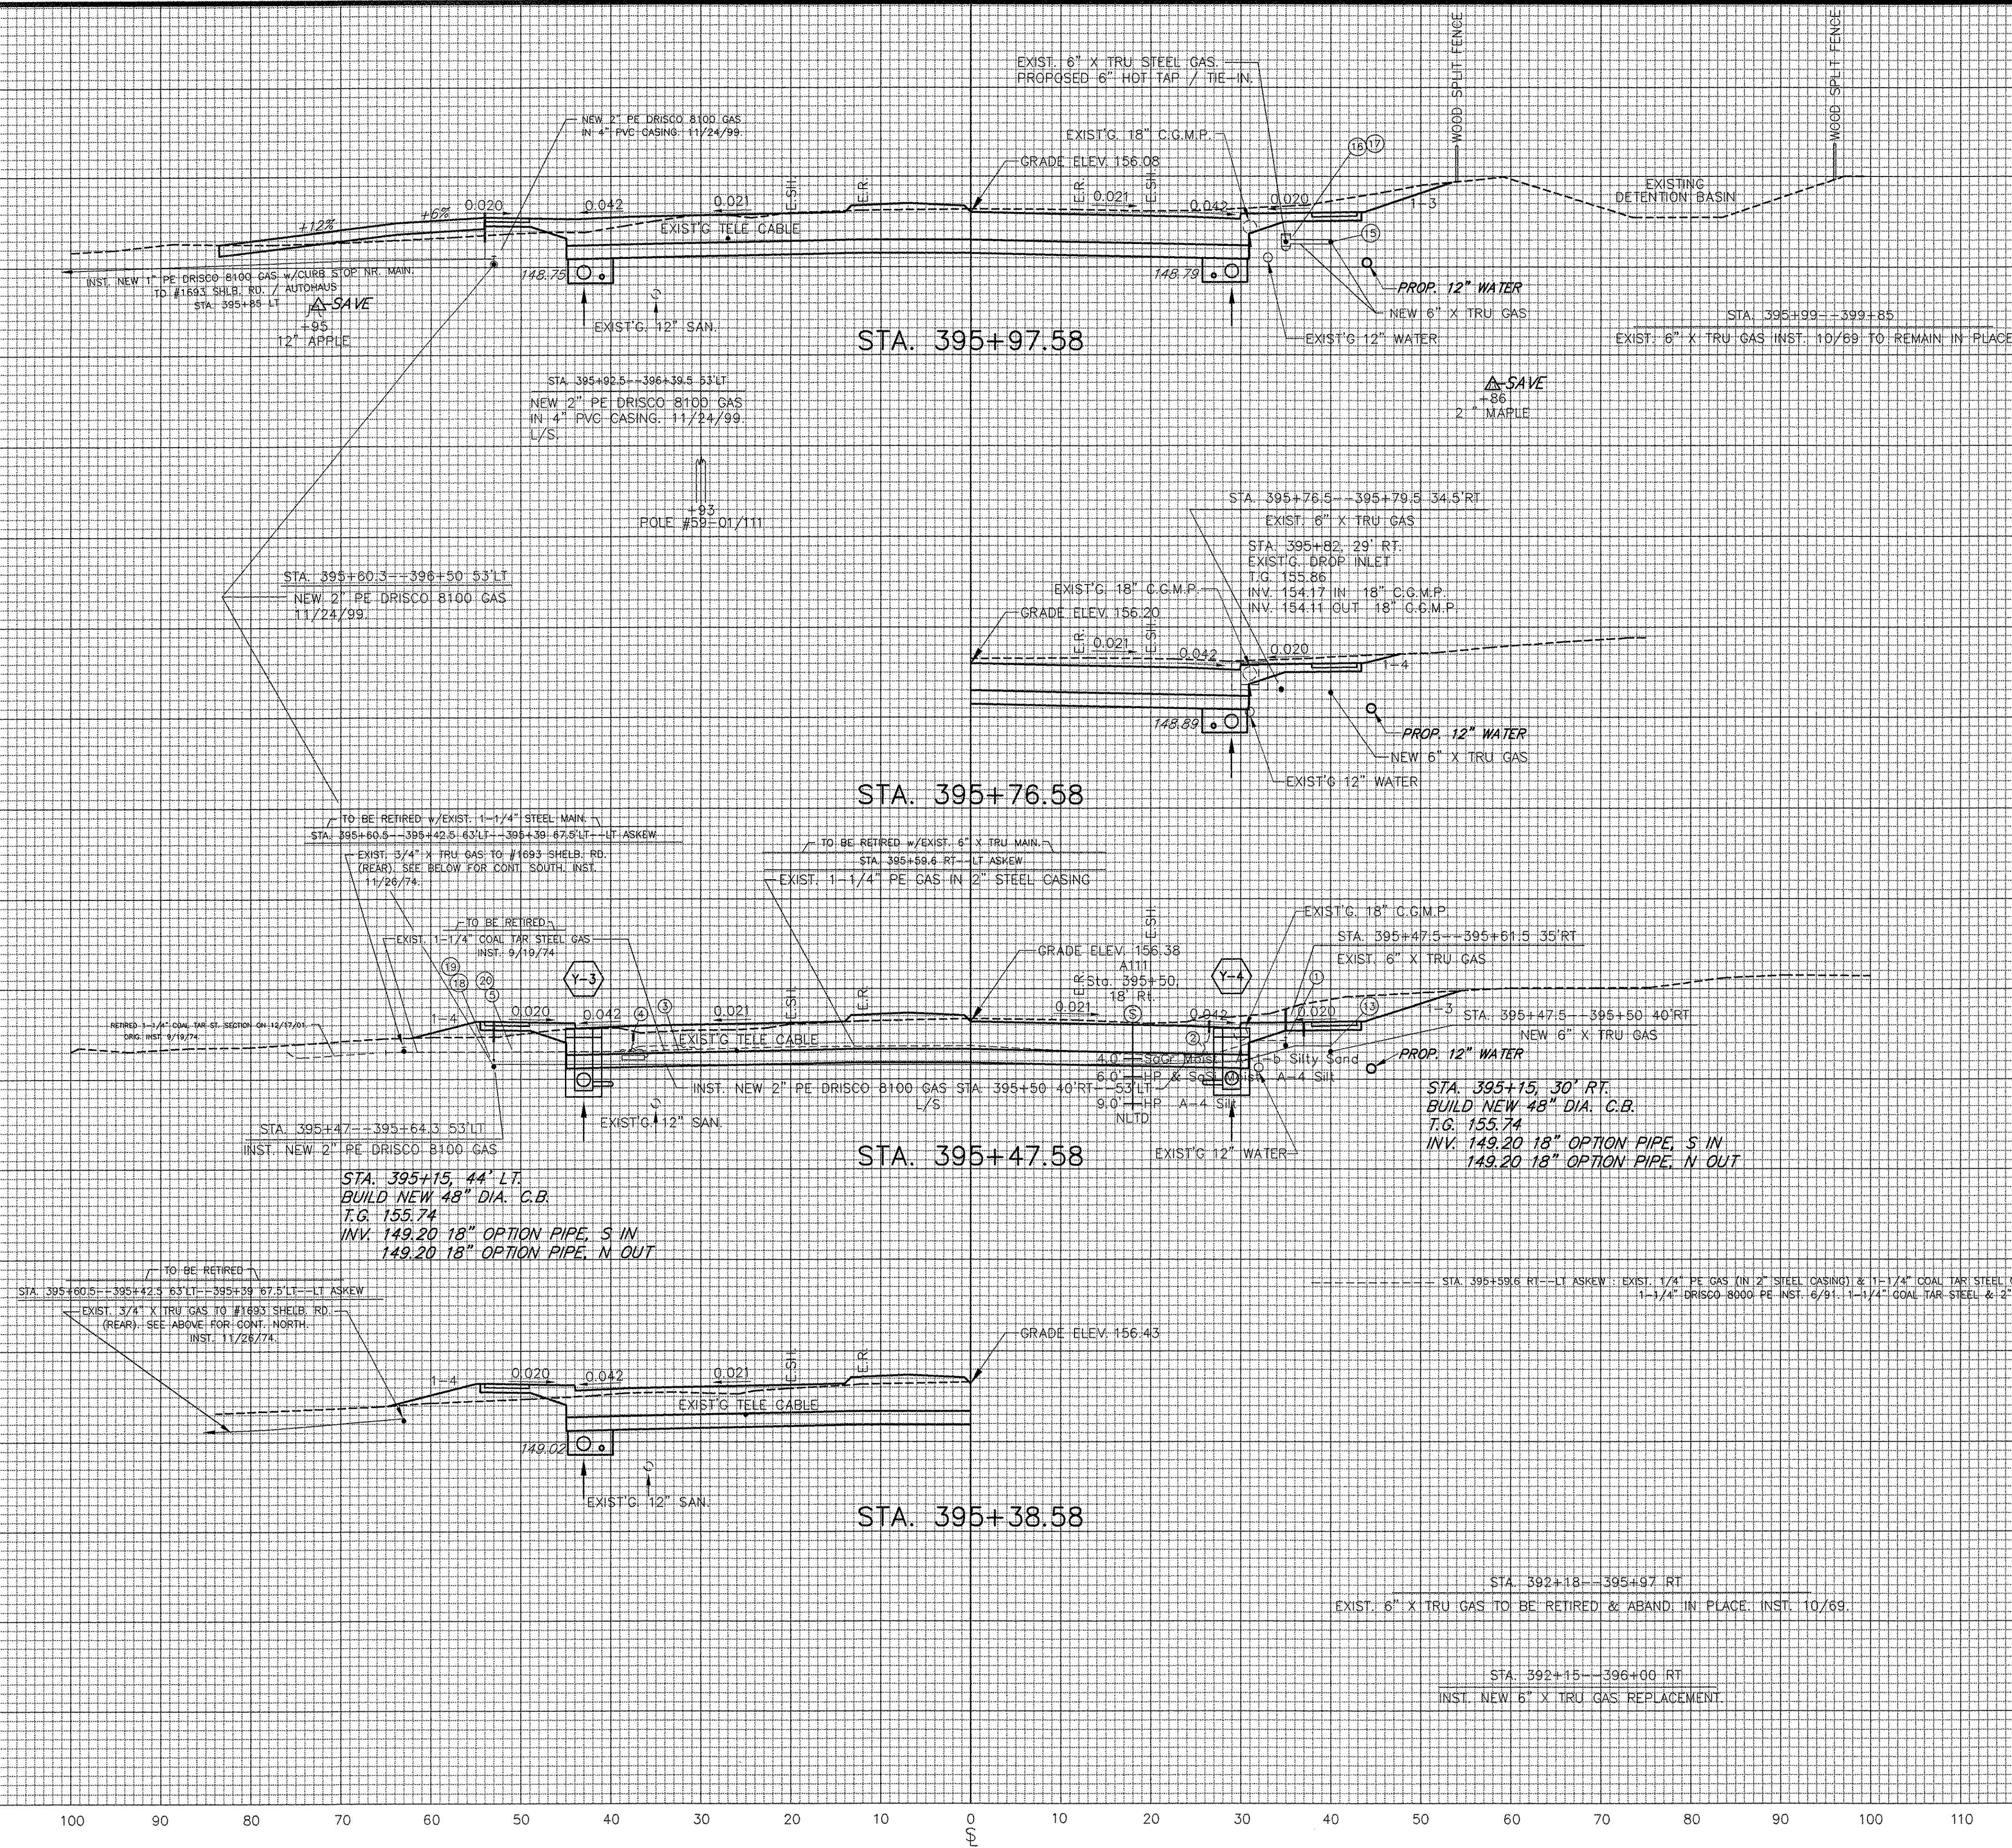

SHELburne - SOUTH BURLINGTON

STA. 395+39 TO STA. 395+98

SURVEYED BY V.S.C. INC. DATE _____

DRAWN BY E.A.A. INC. DATE _____

TRACED BY E.A.A. INC. DATE _____

PROJECT NH-EGC-019-4(28)

CROSS-SECTION DWG. NO. 100

SHEET 192 OF 283