

DATUM ELEV = 145.00

DATUM ELEV = 145.00

DATUM ELEV = 135.00

DATUM ELEV = 140.00

STA. 399+32.58

STA. 398+97.58

STA. 398+47.58

STA. 397+97.58

STA. 398+89, 32' LT.  
BUILD NEW 48" M.H.  
T.C. 154.24  
INV. 145.80 12" PIPE, S IN  
INV. 145.70 12" PIPE, N OUT

SS-18 REMOVE  
STA. 398+95, 37' LT.  
EXIST'G. SAN. MANHOLE #63  
T.C. 145.51  
INV. 145.80 IN 12" A.C.  
INV. 145.70 OUT 12" A.C.

STA. 398+25.69.5' LT  
EXIST'G. STORM MANHOLE  
T.C. ?  
INV. ? IN 60" R.C.P.  
INV. ? OUT 66" C.G.M.P.  
INV. 142.01 18" OPTION PIPE, S IN  
EXIST. INV. 60" C.A.A.P.P. E IN

STA. 397+36, 493' LT  
EXIST'G. 66" C.G.M.P.  
INV. 125.1


STA. 398+42, 65' RT.  
EXIST'G. 60" R.C.P. W/48" C.G.M.P.  
INV. 137.33

STA. 398+40, 66' RT.  
BUILD NEW CONC. HEADWALL  
INV. 137.35 60" C.A.A.P.P. (INLET)

STA. 397+75, 37' RT  
EXIST. 6" X TRU GAS

STA. 397+98, 39' RT  
EXIST. 6" X TRU GAS

STA. 395+99---399+85 RT  
EXIST. 6" X TRU GAS TO REMAIN IN PLACE.  
ORIGINALLY INST. OCTOBER OF 1969.

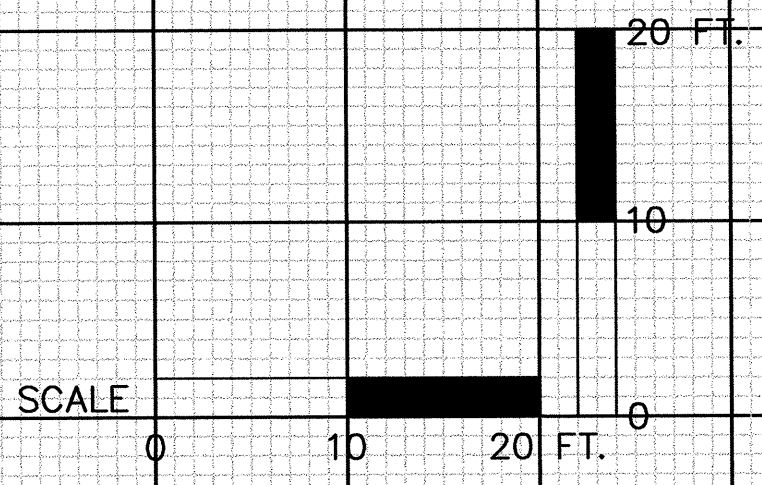

**ERDMAN ANTHONY**  
CONSULTING ENGINEERS  
Rochester, New York    Camp Hill, Pennsylvania  
Boston, Massachusetts

130    120    110    100    90    80    70    60    50    40    30    20    10    0    10    20    30    40    50    60    70    80    90    100    110    120

AS-BUILT REVISIONS		REVISED SEWER DESIGN
NO.	DATE	DESCRIPTION
1.	8/29/06	CHANGES MADE PER AS-BUILTS MARK UPS
	4/4/03	

SHELburnE - SOUTH BURLINGTON  
STA. 397+98 TO STA. 399+33  
SURVEYED BY V.S.C. INC. DATE \_\_\_\_\_  
DRAWN BY E.A.A. INC. DATE \_\_\_\_\_  
TRACED BY E.A.A. INC. DATE \_\_\_\_\_  
PROJECT NH-EGC-019-4(28)  
CROSS-SECTION DWG. NO. 102  
SHEET 194R OF 283