

DATUM ELEV = 145.00

STA. 400+55, 44' LT.  
BUILD NEW 48" DIA. C.B.  
T.G. 152.94  
INV. 146.40 18" OPTION PIPE, N OUT

STA. 400+47.58

DATUM ELEV = 145.00

EXIST. 1 1/4" X TRU GAS TO 1875 SHELBY RD. J  
INST. 12/3/69

STA. 399+97.58

STA. 400+05, 30' RT.  
BUILD NEW 48" DIA. C.B.  
T.G. 153.19  
INV. 147.65 18" OPTION PIPE, N OUT

DATUM ELEV = 145.00


TIE-IN TO EXISTING 8" A.C.

STA. 399+47.58

NEW 8" DI. CROSSING (W/VALVE)  
IN 16" STEEL SLEEVE (JACK & BORE)  
@ STA 399+60

DATUM ELEV = 145.00

STA. 399+39.58

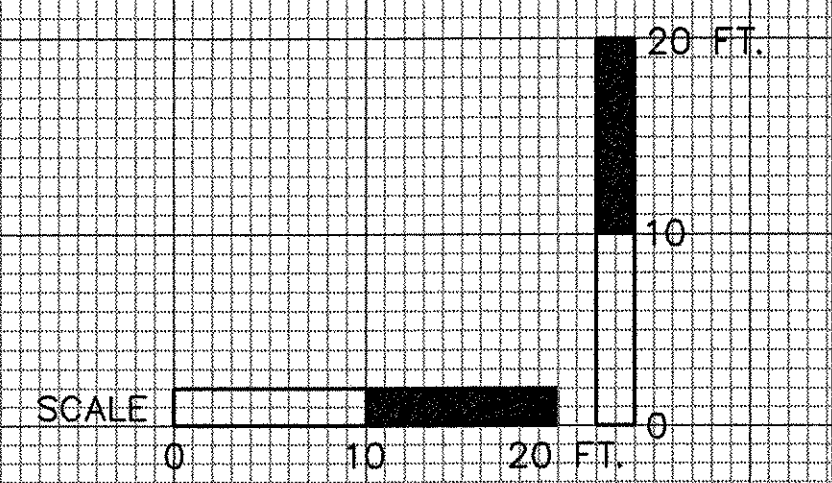

STA. 399+99 - 399+85 RT  
EXIST. 6" X TRU GAS TO REMAIN IN PLACE  
ORIGINALLY INST. OCTOBER OF 1969.

SHELBURNE - SOUTH BURLINGTON

STA. 399+40 TO STA. 400+48

SURVEYED BY V.S.C. INC. DATE \_\_\_\_\_

DRAWN BY E.A.A. INC. DATE \_\_\_\_\_

TRACED BY E.A.A. INC. DATE \_\_\_\_\_

PROJECT NH-EGC-019-4(28)

CROSS-SECTION DWG. NO. 103

SHEET 195 OF 283